

**FIELD EVALUATION SHEET**

NAME Cindy Gellner PERMIT # 2016-000379  
 PARCEL # 01-1-169000 TWP 47-27 SECTION 31

**CHECK THE FOLLOWING PRIOR TO INSPECTION**

B. Hargrave NAME OF SITE EVALUATOR  
 \_\_\_\_\_ NAME OF DESIGNER  
 \_\_\_\_\_ NAME OF INSTALLER

~~No~~ Yes LOT OF RECORD BEFORE 1-21-92 (SL) IR 1-10-95 (NSL), IF NO, ALT. SITE?   
 \_\_\_\_\_ SITE PLAN WITH SETBACK DISTANCES AND DIMENSIONS  
 \_\_\_\_\_ ARE ISTS SITES PROTECTED FROM DAMAGE? IF NOT, WHEN \_\_\_\_\_  
 \_\_\_\_\_ DESIGN \_\_\_\_\_ PERC TESTS \_\_\_\_\_ SOIL BORINGS, 2 PER SITE  
 \_\_\_\_\_ NUMBER OF BEDROOMS (INCLUDE POTENTIAL)  
 \_\_\_\_\_ CROSS SECTION SHEET \_\_\_\_\_ TRENCH DESIGN SHEET  
 \_\_\_\_\_ MOUND DESIGN SHEET \_\_\_\_\_ OTHER OR PERFORM.  
 \_\_\_\_\_ PRESSURE DISTRIBUTION SHEET \_\_\_\_\_ PUMP CALC. TEST  
 \_\_\_\_\_ WATER USE CALCULATIONS \_\_\_\_\_  
 \_\_\_\_\_ GARBAGE DISPOSAL \_\_\_\_\_ HOT TUB  
 \_\_\_\_\_ EASEMENTS ON LOT, IS ROAD PUBLIC OR PRIVATE SEE DEED/PLAT  
 \_\_\_\_\_ NATURAL LANDSCAPE PROTECTION PLAN

STAKING: BUILDINGS \_\_\_\_\_, DRAINFIELD \_\_\_\_\_, BORINGS \_\_\_\_\_, WELL \_\_\_\_\_  
 BUILDING SETBACKS: ROAD \_\_\_\_\_, SIDE \_\_\_\_\_, REAR \_\_\_\_\_, BLUFF \_\_\_\_\_,  
 LAKE/RIVER \_\_\_\_\_

COMPLETE DURING SITE EVALUATION  
 BUILDINGS STAKED \_\_\_\_\_ DRAINFIELD STAKED \_\_\_\_\_ BORINGS STAKED \_\_\_\_\_  
 \_\_\_\_\_ WELL STAKED

**SETBACKS (MEASURE DISTANCE)**

	<u>DRAINFIELD</u>	<u>HOUSE</u>
FLOOD PLAIN	YES/NO	YES/ <del>NO</del>
WETLANDS	YES/NO	YES/ <del>NO</del>
LAKE, RIVER, PROTECTED WATERS	_____	_____
ROAD RIGHT OF WAY	_____	_____
BLUFF	_____	_____
SIDE LOT LINE	_____	_____
REAR LOT LINE	_____	_____
HOUSE OR OTHER STRUCTURE	_____	_____
WELL	_____	_____
EASEMENTS	_____	_____
NEIGHBORING WELL (S) TO ISTS	_____ (1) _____ (2) _____ (3) _____ (4)	_____
DRAINFIELD AREA DISTURBED	_____	_____

*see site plan*


CONFORMING SEPTIC SYSTEM: \_\_\_\_\_ YES  NO If no, list reasons below.  
 COMMENTS OR PROBLEMS (drainage, swales, wetlands, need gutters, etc.) \_\_\_\_\_

New system to be installed

APPROVED: YES OR NO  
 INSPECTORS NAME Bryan Hargrave DATE 6/13/2016 # PICTURES 4

SOIL BORING LOGS AND SKETCH PLAN ON REVERSE SIDE

320-232-3177

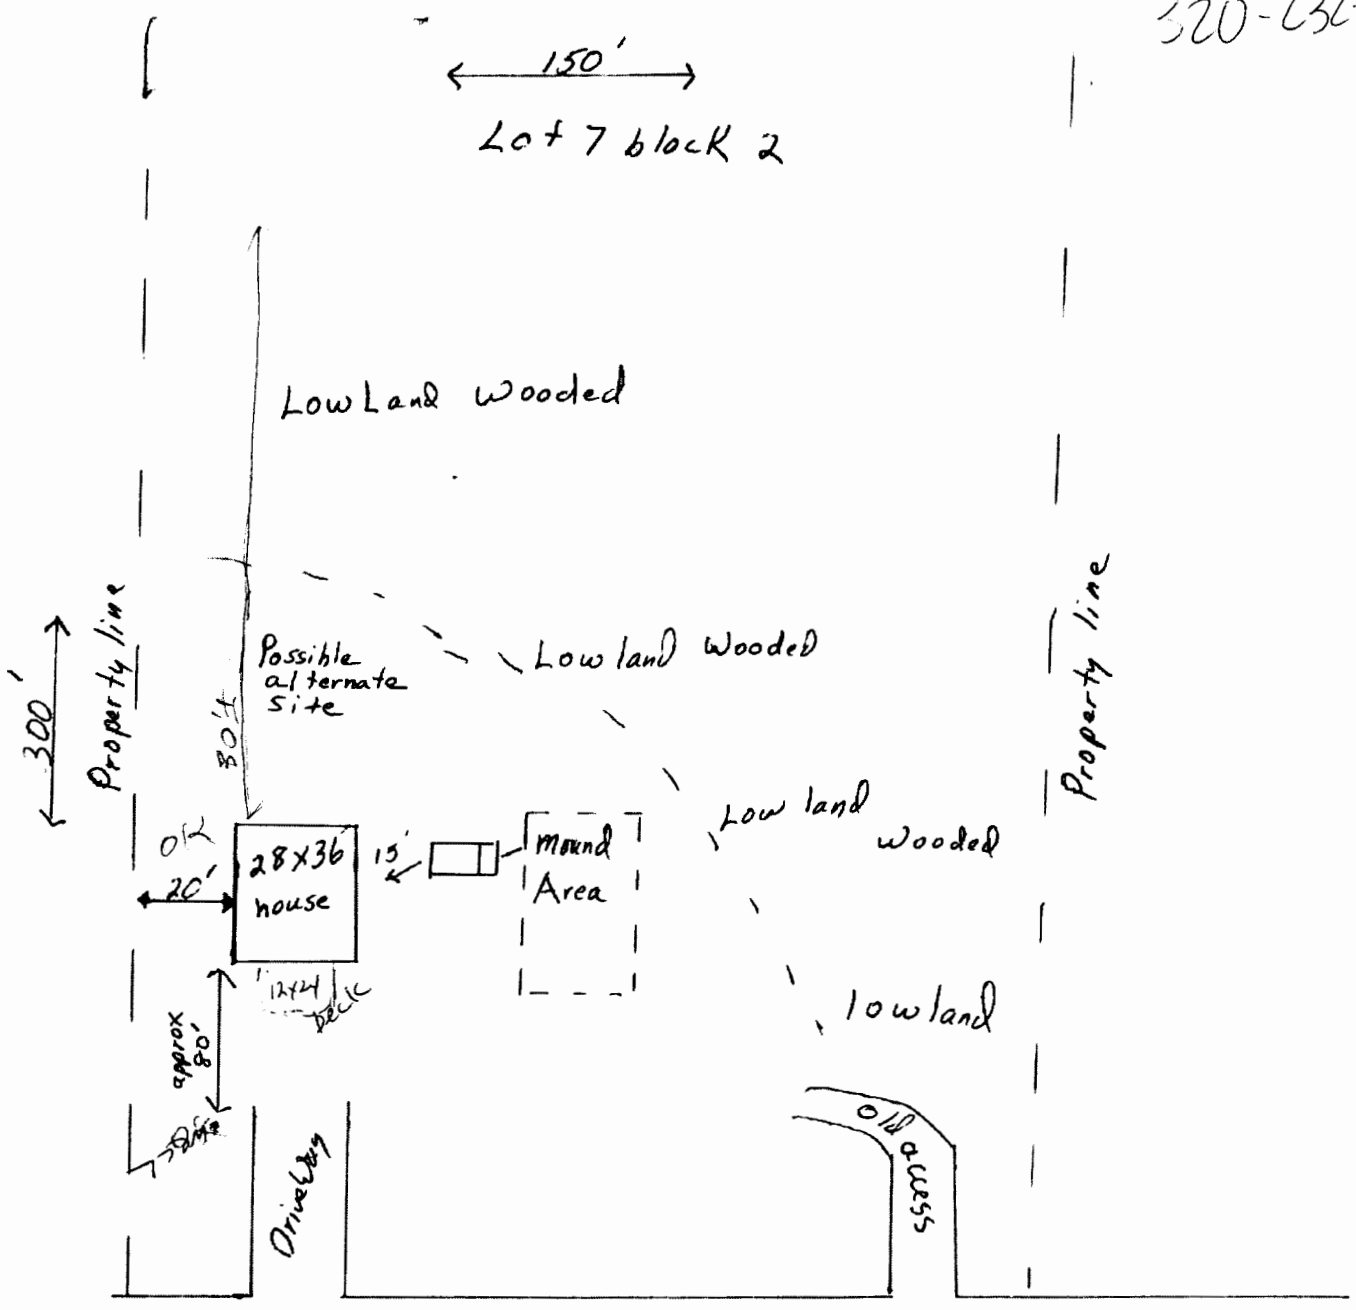

(KT) 5-26-16