

**FIELD EVALUATION SHEET**

NAME Richard Beaudet PERMIT # 2016-000391  
 PARCEL # 35-0-030506 TWP 49-26 SECTION 16

**CHECK THE FOLLOWING PRIOR TO INSPECTION**

B. Hargrave NAME OF SITE EVALUATOR  
 \_\_\_\_\_ NAME OF DESIGNER  
 \_\_\_\_\_ NAME OF INSTALLER

LOT OF RECORD BEFORE 1-21-92 (SL) IR 1-10-95 (NSL), IF NO, ALT. SITE? \_\_\_\_\_  
 \_\_\_\_\_ SITE PLAN WITH SETBACK DISTANCES AND DIMENSIONS  
 \_\_\_\_\_ ARE ISTS SITES PROTECTED FROM DAMAGE? IF NOT, WHEN \_\_\_\_\_  
 \_\_\_\_\_ DESIGN \_\_\_\_\_ PERC TESTS \_\_\_\_\_ SOIL BORINGS, 2 PER SITE  
 \_\_\_\_\_ NUMBER OF BEDROOMS (INCLUDE POTENTIAL)  
 \_\_\_\_\_ CROSS SECTION SHEET \_\_\_\_\_ TRENCH DESIGN SHEET  
 \_\_\_\_\_ MOUND DESIGN SHEET \_\_\_\_\_ OTHER OR PERFORM.  
 \_\_\_\_\_ PRESSURE DISTRIBUTION SHEET \_\_\_\_\_ PUMP CALC. TEST  
 \_\_\_\_\_ WATER USE CALCULATIONS \_\_\_\_\_  
 \_\_\_\_\_ GARBAGE DISPOSAL \_\_\_\_\_ HOT TUB  
 \_\_\_\_\_ EASEMENTS ON LOT, IS ROAD PUBLIC OR PRIVATE SEE DEED/PLAT  
 \_\_\_\_\_ NATURAL LANDSCAPE PROTECTION PLAN

STAKING: BUILDINGS \_\_\_\_\_, DRAINFIELD \_\_\_\_\_, BORINGS \_\_\_\_\_, WELL \_\_\_\_\_  
 BUILDING SETBACKS: ROAD \_\_\_\_\_, SIDE \_\_\_\_\_, REAR \_\_\_\_\_, BLUFF \_\_\_\_\_,  
 LAKE/RIVER \_\_\_\_\_

**COMPLETE DURING SITE EVALUATION**

BUILDINGS STAKED \_\_\_\_\_ DRAINFIELD STAKED \_\_\_\_\_ BORINGS STAKED \_\_\_\_\_  
 \_\_\_\_\_ WELL STAKED

**SETBACKS (MEASURE DISTANCE)**

	<u>DRAINFIELD</u>	<u>HOUSE</u>
FLOOD PLAIN	YES/NO	YES/ <del>NO</del>
WETLANDS	YES/NO	YES/ <del>NO</del>
LAKE, RIVER, PROTECTED WATERS	_____	_____
ROAD RIGHT OF WAY	_____	_____
BLUFF	_____	_____
SIDE LOT LINE	_____	_____
REAR LOT LINE	_____	_____
HOUSE OR OTHER STRUCTURE	_____	_____
WELL	_____	_____
EASEMENTS	_____	_____
NEIGHBORING WELL (S) TO ISTS	(1) _____ (2) _____	(3) _____ (4) _____
DRAINFIELD AREA DISTURBED	_____	_____

*see site plan.*

CONFORMING SEPTIC SYSTEM:  YES \_\_\_\_\_ NO If no, list reasons below.  
 COMMENTS OR PROBLEMS (drainage, swales, wetlands, need gutters, etc.) \_\_\_\_\_

APPROVED: YES OR NO


INSPECTORS NAME Bryan Hargrave DATE 6/9/2016 # PICTURES 8

SOIL BORING LOGS AND SKETCH PLAN ON REVERSE SIDE

# AITKIN COUNTY BUILDING PERMIT SITE PLAN

16x22 addn (352 sqft)  
8x22 addn (176 sqft)

Please indicate the location of: Wells, well setback to system components, buildings, septic system components, reserved septic system area, property lines, waterways, and buried lines. Include size, length, and appropriate distances from fixed reference points. Provide a North directional arrow!

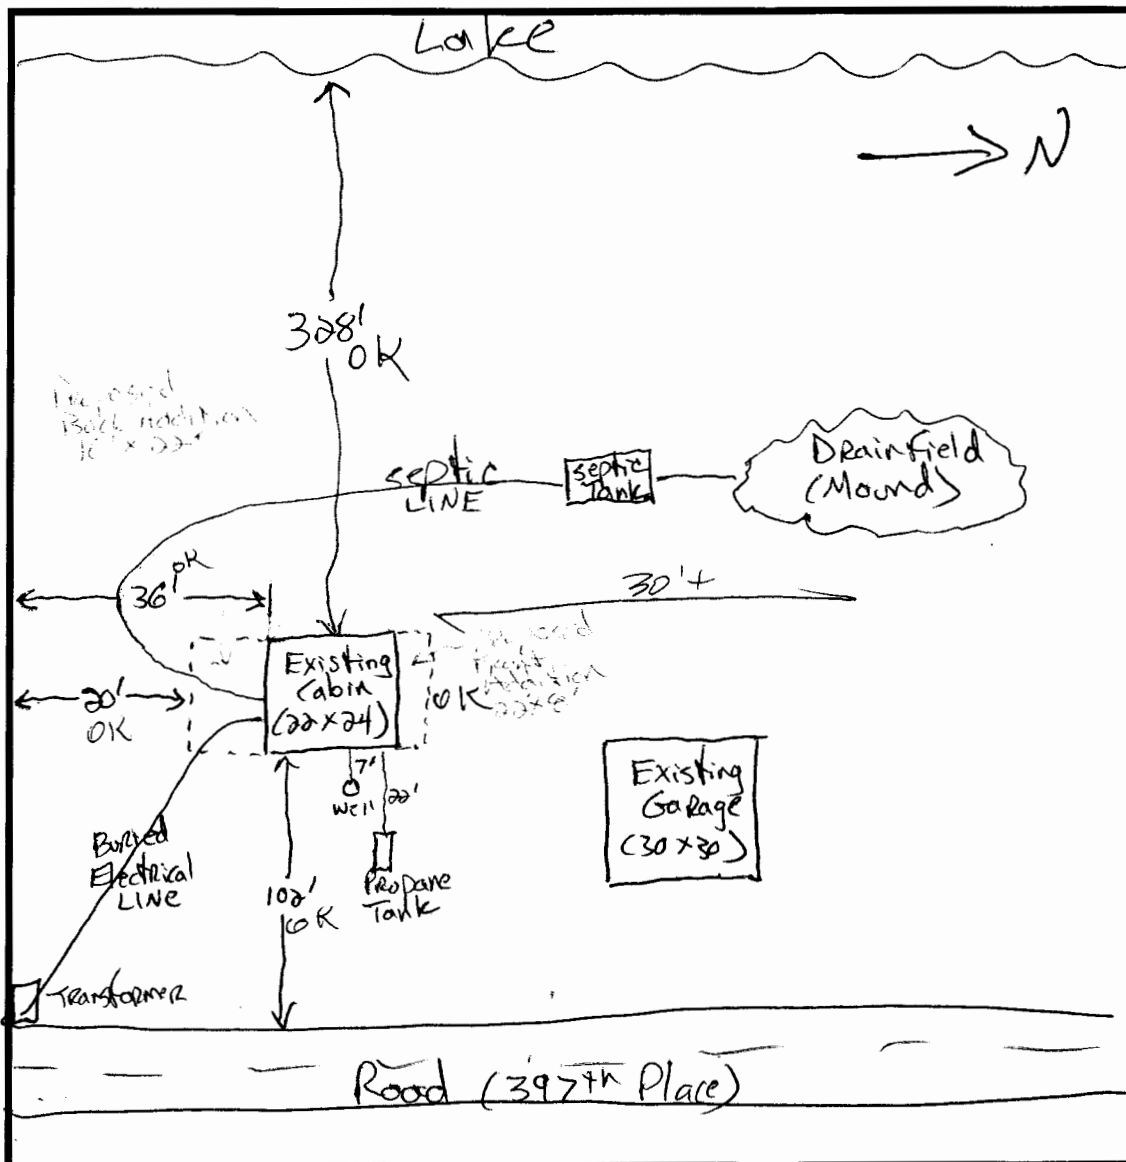

(well is 104' deep)