

FIELD EVALUATION SHEET

NAME Jerry Weiler PERMIT # 2016-000407
PARCEL # 17-0-018201 TWP 46-24 SECTION 13

CHECK THE FOLLOWING PRIOR TO INSPECTION

B. Hargrave NAME OF SITE EVALUATOR
NAME OF DESIGNER
NAME OF INSTALLER

LOT OF RECORD BEFORE 1-21-92 (SL) IR 1-10-95 (NSL), IF NO, ALT. SITE? _____
SITE PLAN WITH SETBACK DISTANCES AND DIMENSIONS _____
ARE ISTS SITES PROTECTED FROM DAMAGE? IF NOT, WHEN _____
DESIGN _____ PERC TESTS _____ SOIL BORINGS, 2 PER SITE _____
NUMBER OF BEDROOMS (INCLUDE POTENTIAL) _____
CROSS SECTION SHEET _____ TRENCH DESIGN SHEET _____
MOUND DESIGN SHEET _____ OTHER OR PERFORM. _____
PRESSURE DISTRIBUTION SHEET _____ PUMP CALC. TEST _____
WATER USE CALCULATIONS _____
GARBAGE DISPOSAL _____ HOT TUB _____
EASEMENTS ON LOT, IS ROAD PUBLIC OR PRIVATE SEE DEED/PLAT _____
NATURAL LANDSCAPE PROTECTION PLAN _____

STAKING: BUILDINGS _____, DRAINFIELD _____, BORINGS _____, WELL _____
BUILDING SETBACKS: ROAD _____, SIDE _____, REAR _____, BLUFF _____,
LAKE/RIVER _____

COMPLETE DURING SITE EVALUATION
BUILDINGS STAKED _____ DRAINFIELD STAKED _____ BORINGS STAKED _____
WELL STAKED _____

SETBACKS (MEASURE DISTANCE)

	<u>DRAINFIELD</u>	<u>HOUSE</u>
	YES/NO	YES/NO
FLOOD PLAIN		
WETLANDS		
LAKE, RIVER, PROTECTED WATERS		
ROAD RIGHT OF WAY		
BLUFF		
SIDE LOT LINE		
REAR LOT LINE		
HOUSE OR OTHER STRUCTURE		
WELL		
EASEMENTS		
NEIGHBORING WELL (S) TO ISTS	(1) _____ (2) _____	(3) _____ (4) _____
DRAINFIELD AREA DISTURBED		

see site plan.

CONFORMING SEPTIC SYSTEM: YES NO If no, list reasons below.

COMMENTS OR PROBLEMS (drainage, swales, wetlands, need gutters, etc.) *Permit approved over the ctr. I was there last year for inspection + am familiar with parcel.*




APPROVED: YES OR NO

INSPECTORS NAME Bryn Hargrave DATE 6/13/2016 # PICTURES 8

SOIL BORING LOGS AND SKETCH PLAN ON REVERSE SIDE

(from 2015)

500 FT
FROM
Rice
River

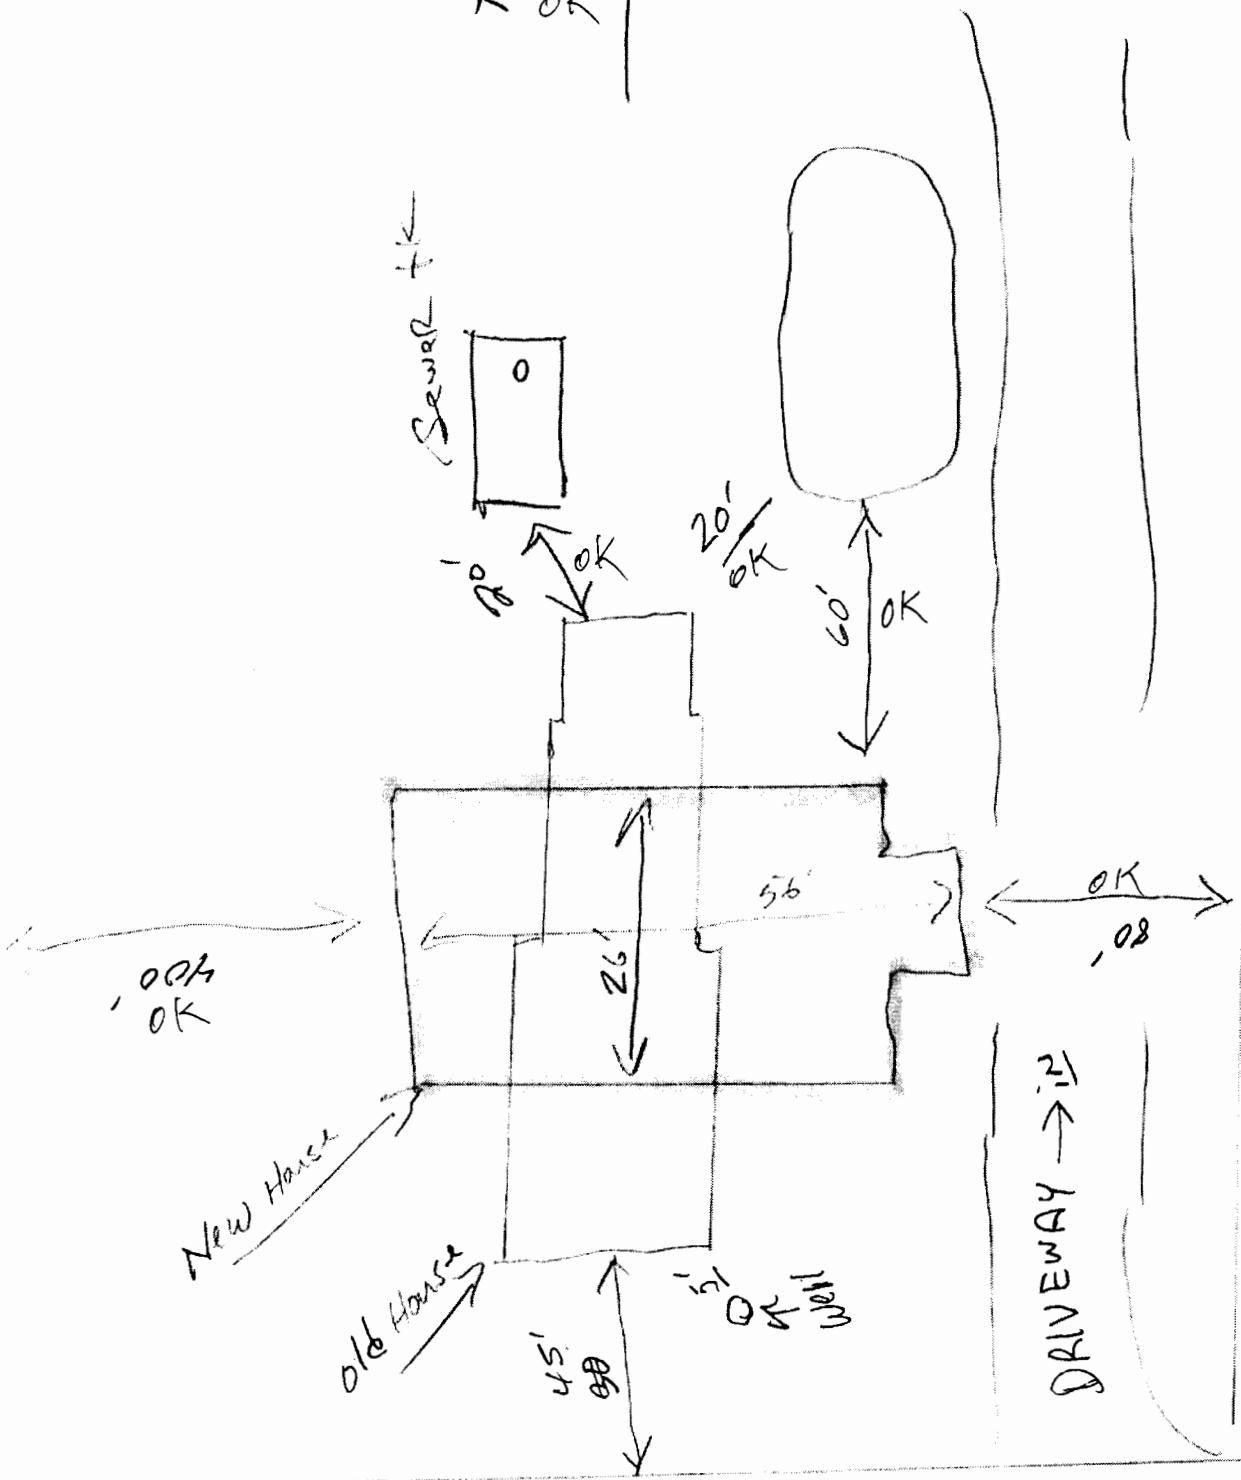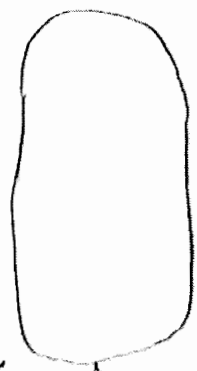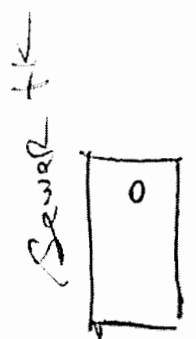

310th Lane