

A. M. & Associates, Inc.

29465 442nd Lane
Palisade, MN 56469
(218) 768-4430

Michael D. O'Keeffe

SEPTIC SYSTEMS
DESIGNS * INSPECTIONS * MAINTENANCE
MPCA #1357

THE ENCLOSED INDIVIDUAL SEWAGE TREATMENT SYSTEM (ISTS)
IS DESIGNED SPECIFICALLY FOR:

JAMES SIMPSON
49440 405th Place
Palisade, MN 56469

For property located at above address

Esquagamah Lake
Unorganized Territory
Sec. 13, Twp. 49, Rge. 27

Parcel # 52-1-043800

May 31, 2016

APPROVED

ONSITE INSPECTION
 NO ONSITE INSPECTION

SIGN  DATE 6-1-14

~~ADD-1650~~ HOLDING TANK
1500

FOR EXTRA CAPACITY, HOMEOWNER HAS REQUESTED AN ADDITIONAL HOLDING TANK.


Note to Property Owner and Installer:

1. Install a ~~1650~~ Gallon Tank to be used as an extra Holding Tank.
1500
2. An Alarm device is to be installed on the Holding Tank to minimize the chance of accidental sewage overflow. It shall identify when the Holding Tank is at 75% capacity.
3. THE PROPERTY OWNER *MUST* HAVE A SEPARATE MONITORING AND DISPOSAL CONTRACT FOR THE TANK, SIGNED BY BOTH THE OWNER AND A LICENSED PUMPER. THE CONTRACTS MUST GUARANTEE THE REMOVAL OF THE TANK'S CONTENTS PRIOR TO OVERFLOW OR ANY DISCHARGE.

****A SIGNED COPY OF THIS CONTRACT *MUST* ACCOMPANY THIS DESIGN WHEN REQUESTING A PERMIT FROM AITKIN COUNTY PLANNING AND ZONING.

4. Installer is to contact Designer for any changes or questions.

JAMES SIMPSON
Parcel# 52-1-043800
SEPTIC DESIGN
5/31/2016

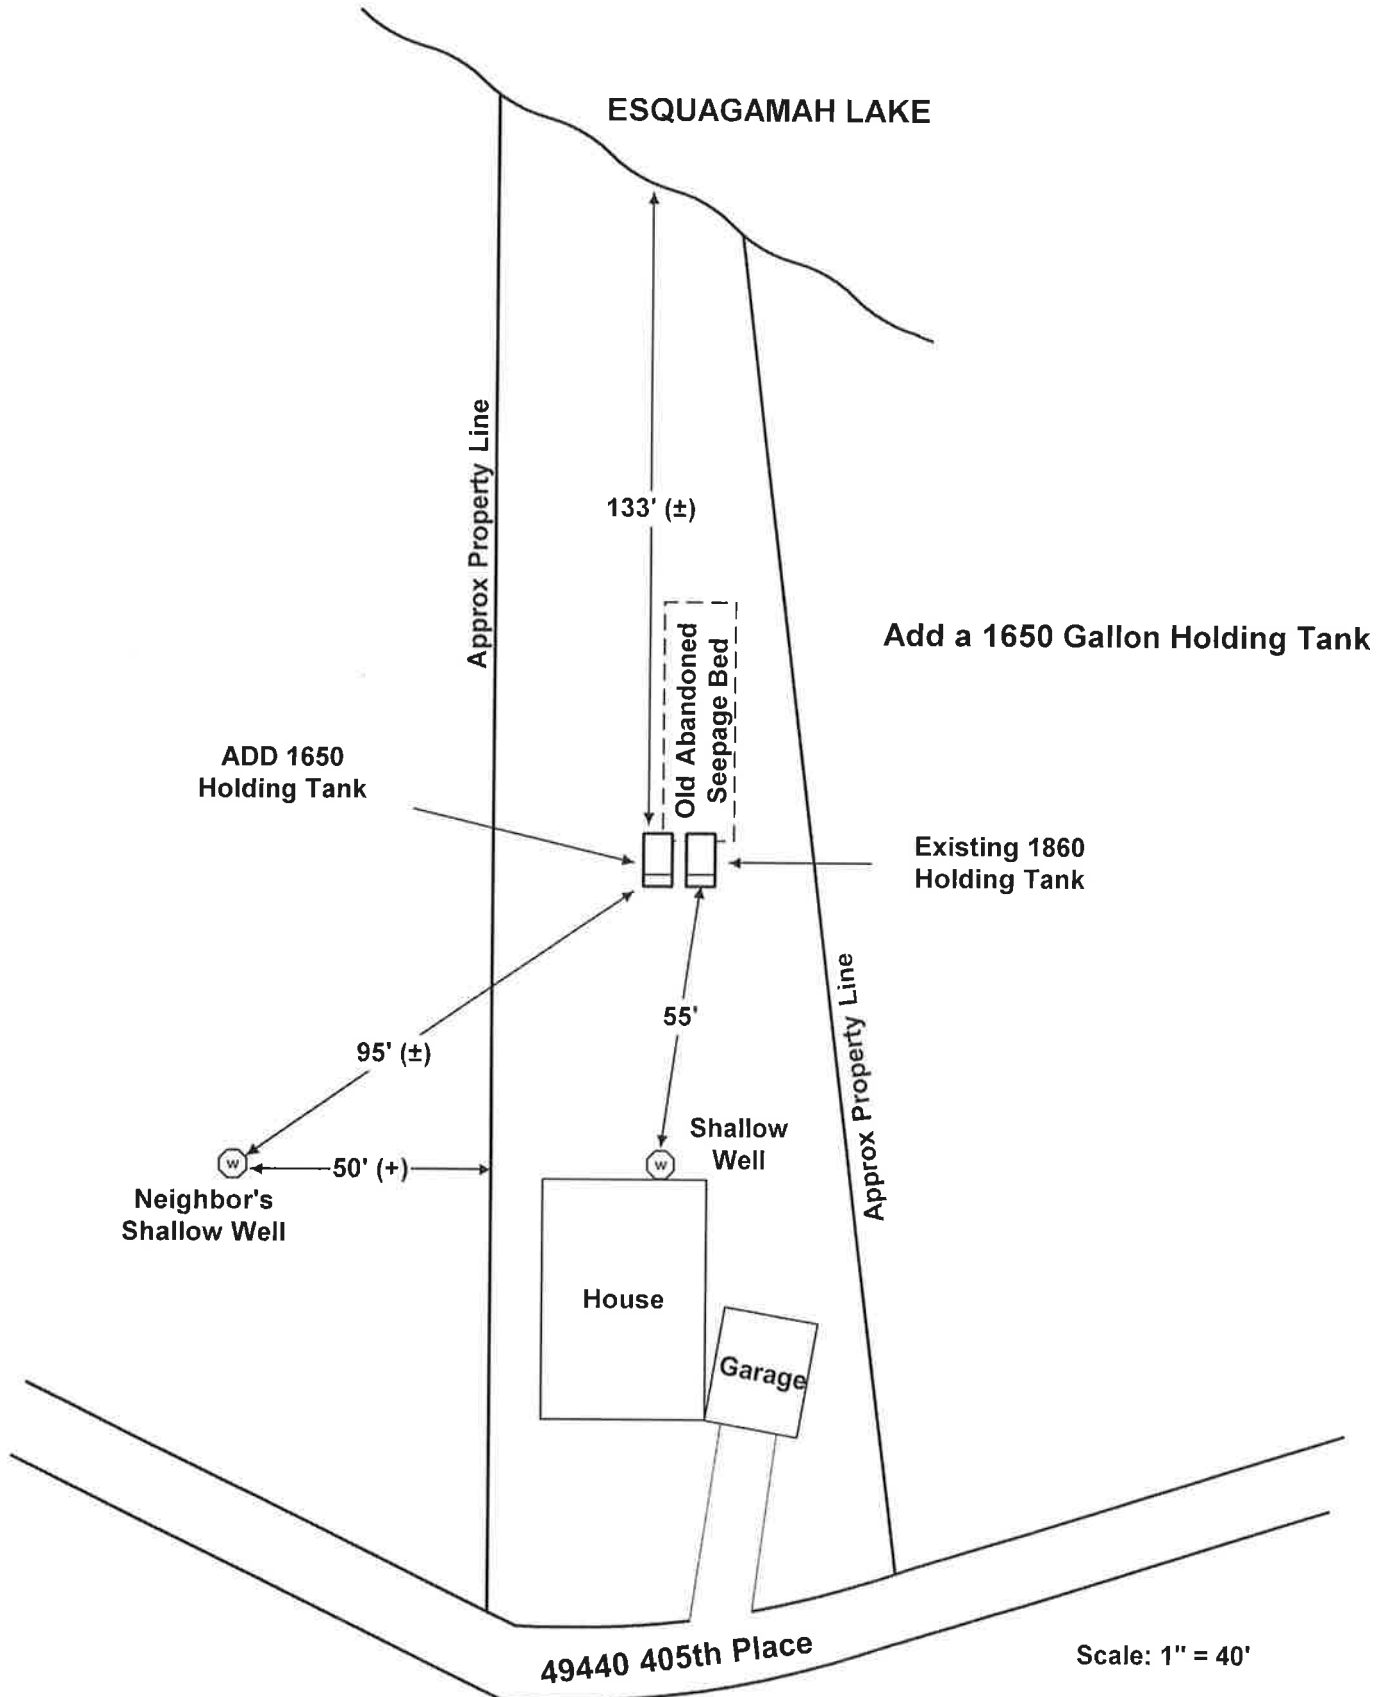

HOLDING TANK PUMPING SERVICE AGREEMENT

Permit # _____ Address 4940 40TH PLACE PAULSDENA ME 0469

THIS AGREEMENT, entered into by and between Aitkin County Registered Septic Tank Pumper, _____, hereinafter referred to as "Contractor", and Jim Simpson, hereinafter referred to as "Homeowner".

WHEREAS, Homeowner desires and is required to retain individual sewage treatment system holding tank services to protect the environment and to obtain a certificate of compliance from Aitkin County; and

WHEREAS, the Contractor desires to provide sewage treatment system pumping services to Homeowner as necessary and in accordance with the terms and conditions outlined herein.

NOW THEREFORE, in consideration of the mutual promises contained herein, Parties do hereby agree as follows:

1. **TERM.** The term of this Agreement shall be from _____ to final installation of an Aitkin County approved sewage treatment system or connection to a Municipal Sewage Treatment System, unless earlier terminated as provided herein. The parties understand and agree that this Agreement is intended to arrange for the provision of pumping services so that Homeowner may occupy the home pursuant to a certificate of compliance to be issued by the Aitkin County Environmental Services Department upon execution of this Agreement. Homeowner further agrees that at the earliest possible date, Homeowner shall have a permanent sewage treatment system installed in accordance with the Aitkin County Subsurface Sewage Treatment System Ordinance and as approved by the Aitkin County Environmental Services Department or connect to a Municipal Sewage Treatment System. Upon approval by the County of Aitkin of the individual sewage treatment system or connection to a municipal sewer, or approval by Aitkin County Environmental Services of an amended or different contract, this Agreement shall terminate.

2. **FREQUENCY OF PUMPING.** Homeowner agrees that he/she shall not allow the holding tank to overflow or discharge in any manner. Contractor and Homeowner agree that the holding tank shall be pumped in accordance with the following:

- Tank size (gal.) 1500 / (number of household occupants multiplied by 75 gallons per day) = frequency of pumping; or
- Within 24 hours of indication by tank alarm of lack of capacity (applicable only if system has a functional alarm);
- Whichever is greater

Contractor agrees to provide pumping services according to the regular pumping schedule or as needed to prevent discharge. Homeowner shall compensate Contractor as agreed by the parties for pumping services rendered.

3. **INSPECTION.** Holding tanks will be inspected by a licensed pumper at the time of servicing for leaks below the operating depth and whether tank tops, riser joints, and connections leak through visual evidence of major defects.

4. **REPORTING.** Grievances of Homeowner or Contractor shall be reported to the Aitkin County Environmental Services Department by Homeowner or Contractor. Homeowner and Contractor understand that failure to have holding tank pumped as herein specified or the discharge of any contents from the holding tank, regardless of fault, may result in the suspension, cancellation or revocation of the certificate of compliance, and the homeowner may be required to vacate the premises.

Contractor

X Jim Simpson
Homeowner

Date _____

X Date 5-20-16