

FIELD EVALUATION SHEET

NAME Eric Anderson PERMIT # _____
 PARCEL # 15-0-059300 TWP Kimberly SECTION 34

CHECK THE FOLLOWING PRIOR TO INSPECTION

 _____ NAME OF SITE EVALUATOR
 _____ NAME OF DESIGNER
 _____ NAME OF INSTALLER

7 LOT OF RECORD BEFORE 1-21-92 (SL) IR 1-10-95 (NSL), IF NO, ALT. SITE? _____
4 SITE PLAN WITH SETBACK DISTANCES AND DIMENSIONS _____
 ARE ISTS SITES PROTECTED FROM DAMAGE? IF NOT, WHEN _____
 DESIGN _____ PERC TESTS _____ SOIL BORINGS, 2 PER SITE _____
 NUMBER OF BEDROOMS (INCLUDE POTENTIAL) _____
 CROSS SECTION SHEET _____ TRENCH DESIGN SHEET _____
 MOUND DESIGN SHEET _____ OTHER OR PERFORM. _____
 PRESSURE DISTRIBUTION SHEET _____ PUMP CALC. TEST _____
 WATER USE CALCULATIONS _____
 _____ GARBAGE DISPOSAL _____ HOT TUB _____
 _____ EASEMENTS ON LOT, IS ROAD PUBLIC OR PRIVATE SEE DEED/PLAT _____
 _____ NATURAL LANDSCAPE PROTECTION PLAN _____

STAKING: BUILDINGS _____, DRAINFIELD _____, BORINGS _____, WELL _____
 BUILDING SETBACKS: ROAD _____, SIDE _____, REAR _____, BLUFF _____,
 LAKE/RIVER _____

COMPLETE DURING SITE EVALUATION
 _____ BUILDINGS STAKED _____ DRAINFIELD STAKED _____ BORINGS STAKED
 _____ WELL STAKED

SETBACKS (MEASURE DISTANCE)

	<u>DRAINFIELD</u>	<u>HOUSE</u>
FLOOD PLAIN	YES/NO	YES/NO <i>not at residence</i>
WETLANDS	YES/NO	YES/NO
LAKE, RIVER, PROTECTED WATERS	_____	95' to cabin 83' to deck
ROAD RIGHT OF WAY	_____	2300'
BLUFF	_____	N/A
SIDE LOT LINE	_____	10' North
REAR LOT LINE	_____	_____
HOUSE OR OTHER STRUCTURE	_____	_____
WELL	_____	_____
EASEMENTS	_____	_____
NEIGHBORING WELL (S) TO ISTS	(1) _____ (2) _____	(3) _____ (4) _____
DRAINFIELD AREA DISTURBED	_____	_____


CONFORMING SEPTIC SYSTEM: X YES _____ NO If no, list reasons below.

COMMENTS OR PROBLEMS (drainage, swales, wetlands, need gutters, etc.)
Approved using deck encroachment 6.3 B

APPROVED: YES OR NO

INSPECTORS NAME _____ DATE _____ # PICTURES _____

SOIL BORING LOGS AND SKETCH PLAN ON REVERSE SIDE

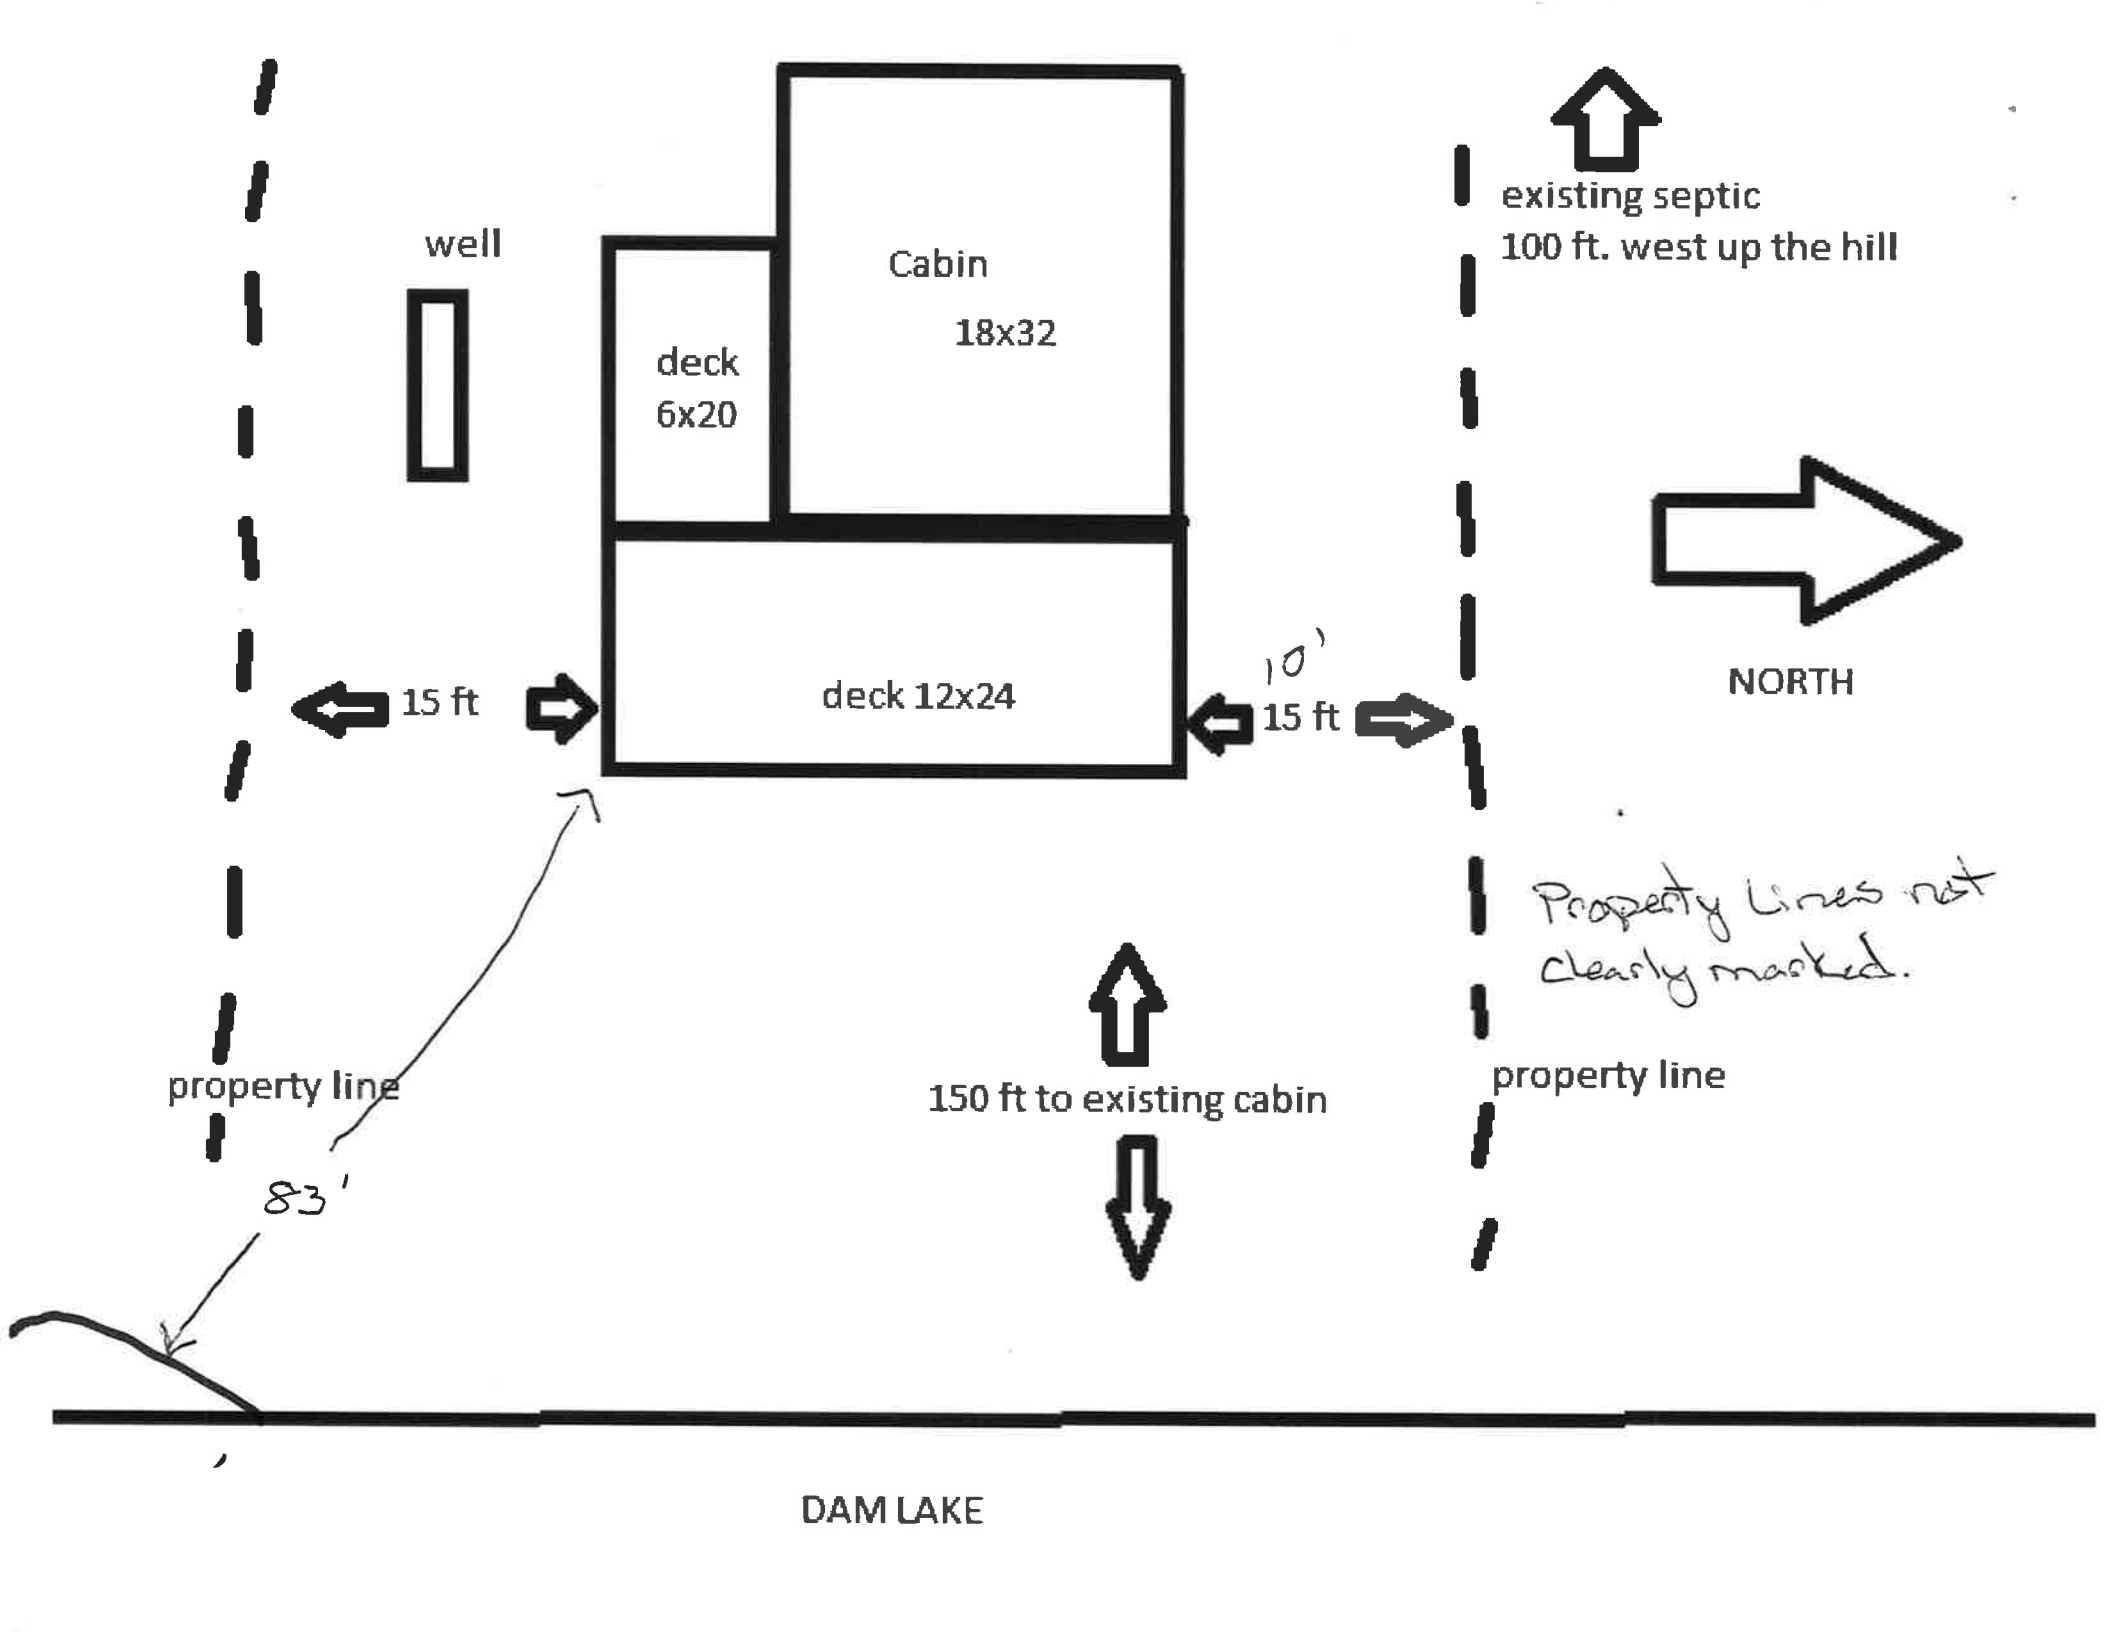

well



deck
6x20

Cabin
18x32


deck 12x24

15 ft

10'

15 ft

existing septic
100 ft. west up the hill

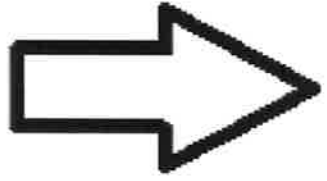

NORTH

property line

83'

150 ft to existing cabin



property line

*Property Lines not
clearly marked.*

DAM LAKE