

FIELD EVALUATION SHEET

NAME Wayne Royer PERMIT # 2016-000436
 PARCEL # 24-1-110600 TWP 46-26 SECTION 4

CHECK THE FOLLOWING PRIOR TO INSPECTION

B. Hargrave NAME OF SITE EVALUATOR
 _____ NAME OF DESIGNER
 _____ NAME OF INSTALLER

LOT OF RECORD BEFORE 1-21-92 (SL) IR 1-10-95 (NSL), IF NO, ALT.SITE? _____
 _____ SITE PLAN WITH SETBACK DISTANCES AND DIMENSIONS
 _____ ARE ISTS SITES PROTECTED FROM DAMAGE? IF NOT, WHEN _____
 _____ DESIGN _____ PERC TESTS _____ SOIL BORINGS, 2 PER SITE
 _____ NUMBER OF BEDROOMS (INCLUDE POTENTIAL)
 _____ CROSS SECTION SHEET _____ TRENCH DESIGN SHEET
 _____ MOUND DESIGN SHEET _____ OTHER OR PERFORM.
 _____ PRESSURE DISTRIBUTION SHEET _____ PUMP CALC. TEST
 _____ WATER USE CALCULATIONS _____
 _____ GARBAGE DISPOSAL _____ HOT TUB
 _____ EASEMENTS ON LOT, IS ROAD PUBLIC OR PRIVATE SEE DEED/PLAT
 _____ NATURAL LANDSCAPE PROTECTION PLAN

STAKING: BUILDINGS _____, DRAINFIELD _____, BORINGS _____, WELL _____
 BUILDING SETBACKS: ROAD _____, SIDE _____, REAR _____, BLUFF _____,
 LAKE/RIVER _____

COMPLETE DURING SITE EVALUATION

BUILDINGS STAKED _____ DRAINFIELD STAKED _____ BORINGS STAKED _____
 _____ WELL STAKED _____

SETBACKS (MEASURE DISTANCE)

	<u>DRAINFIELD</u>	<u>HOUSE</u>
FLOOD PLAIN	YES/NO	YES/NO
WETLANDS	YES/NO	YES/NO
LAKE, RIVER, PROTECTED WATERS	_____	_____
ROAD RIGHT OF WAY	_____	_____
BLUFF	_____	_____
SIDE LOT LINE	_____	_____
REAR LOT LINE	_____	_____
HOUSE OR OTHER STRUCTURE	_____	_____
WELL	_____	_____
EASEMENTS	_____	_____
NEIGHBORING WELL (S) TO ISTS	_____ (1) _____ (2)	_____ (3) _____ (4)
DRAINFIELD AREA DISTURBED	_____	_____

see site plan.

CONFORMING SEPTIC SYSTEM: _____ YES NO If no, list reasons below.

COMMENTS OR PROBLEMS (drainage, swales, wetlands, need gutters, etc.) _____


New system to be installed

APPROVED: YES OR NO Bryan Hargrave

INSPECTORS NAME Bryan Hargrave DATE 6/23/2016 # PICTURES

SOIL BORING LOGS AND SKETCH PLAN ON REVERSE SIDE

SETH LAKE

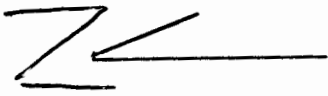


1" = 40'

NORTH LOT LINE

LOT

LOT

SOUTH LOT LINE

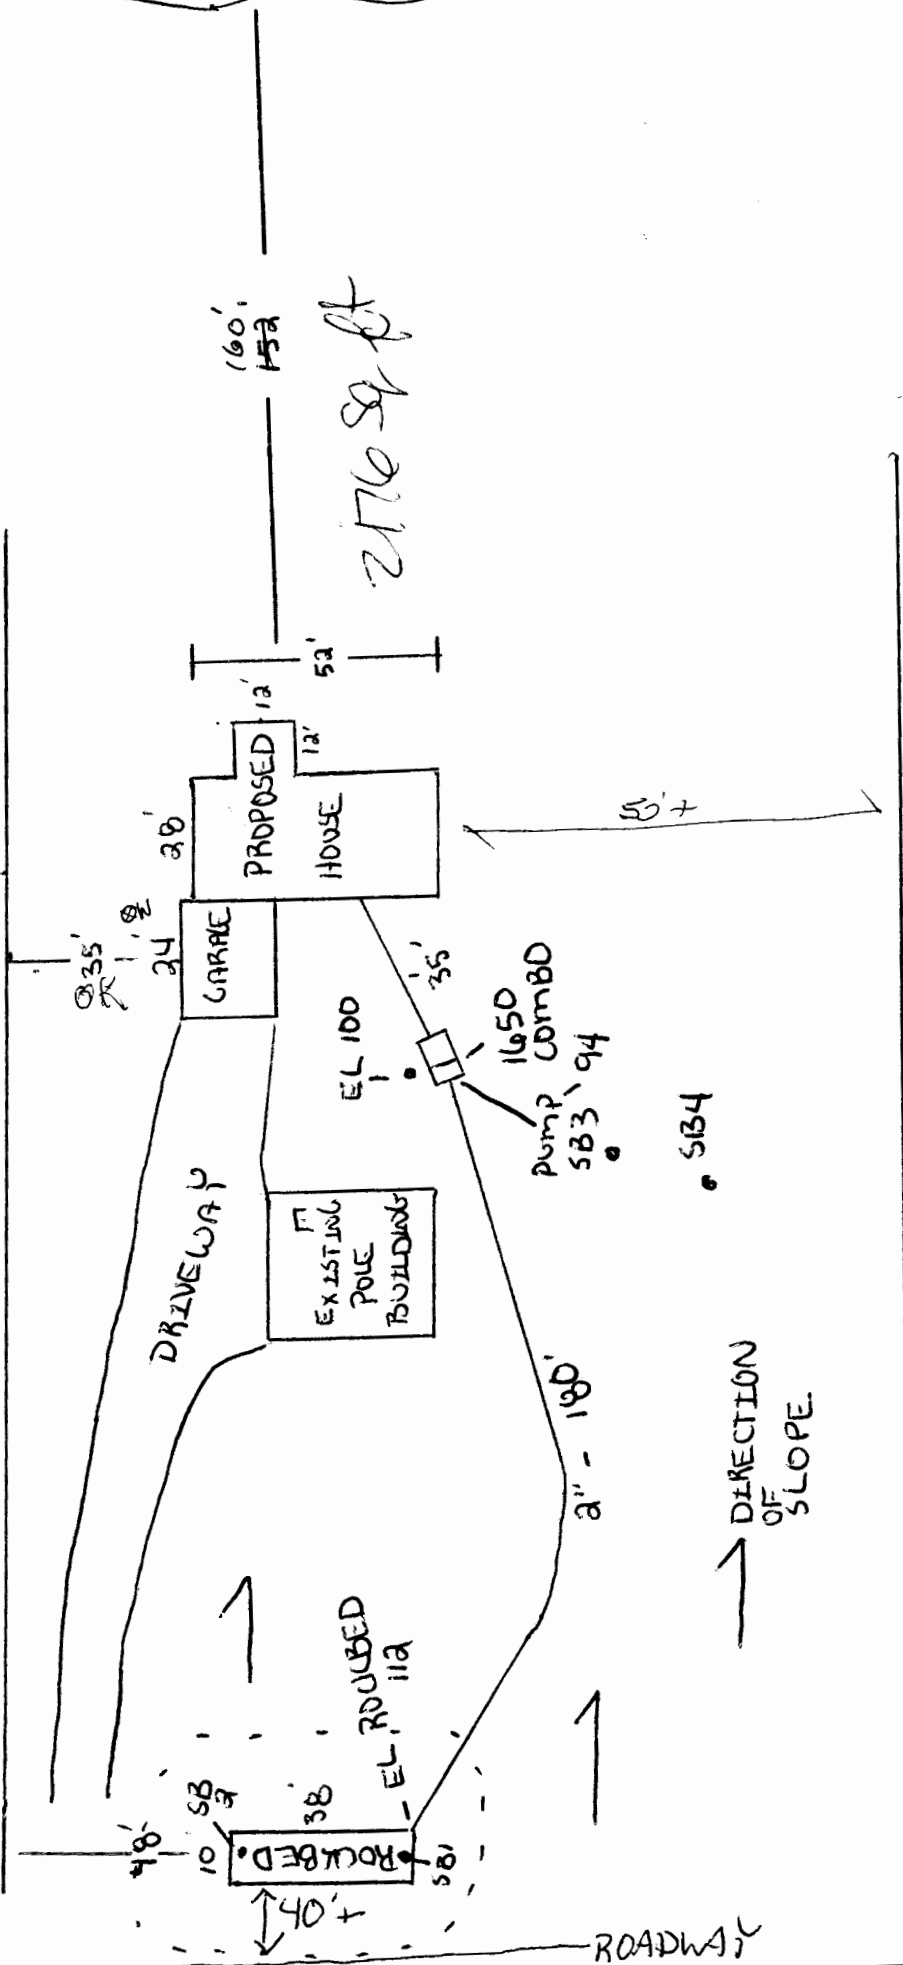

35'

24'

30'

PROPOSED HOUSE

12'

12'

52'

160'

152'

2776 sq ft

EL 100

1650
PUMP COMBO

583, 94

SB 114

50' ±

DIRECTION OF SLOPE

SOUTH LOT LINE

LOT

SOUTH

ROADWAY