


(B2H)

(CHANGES)

WATER CERT - 09/09/15 (93.6)

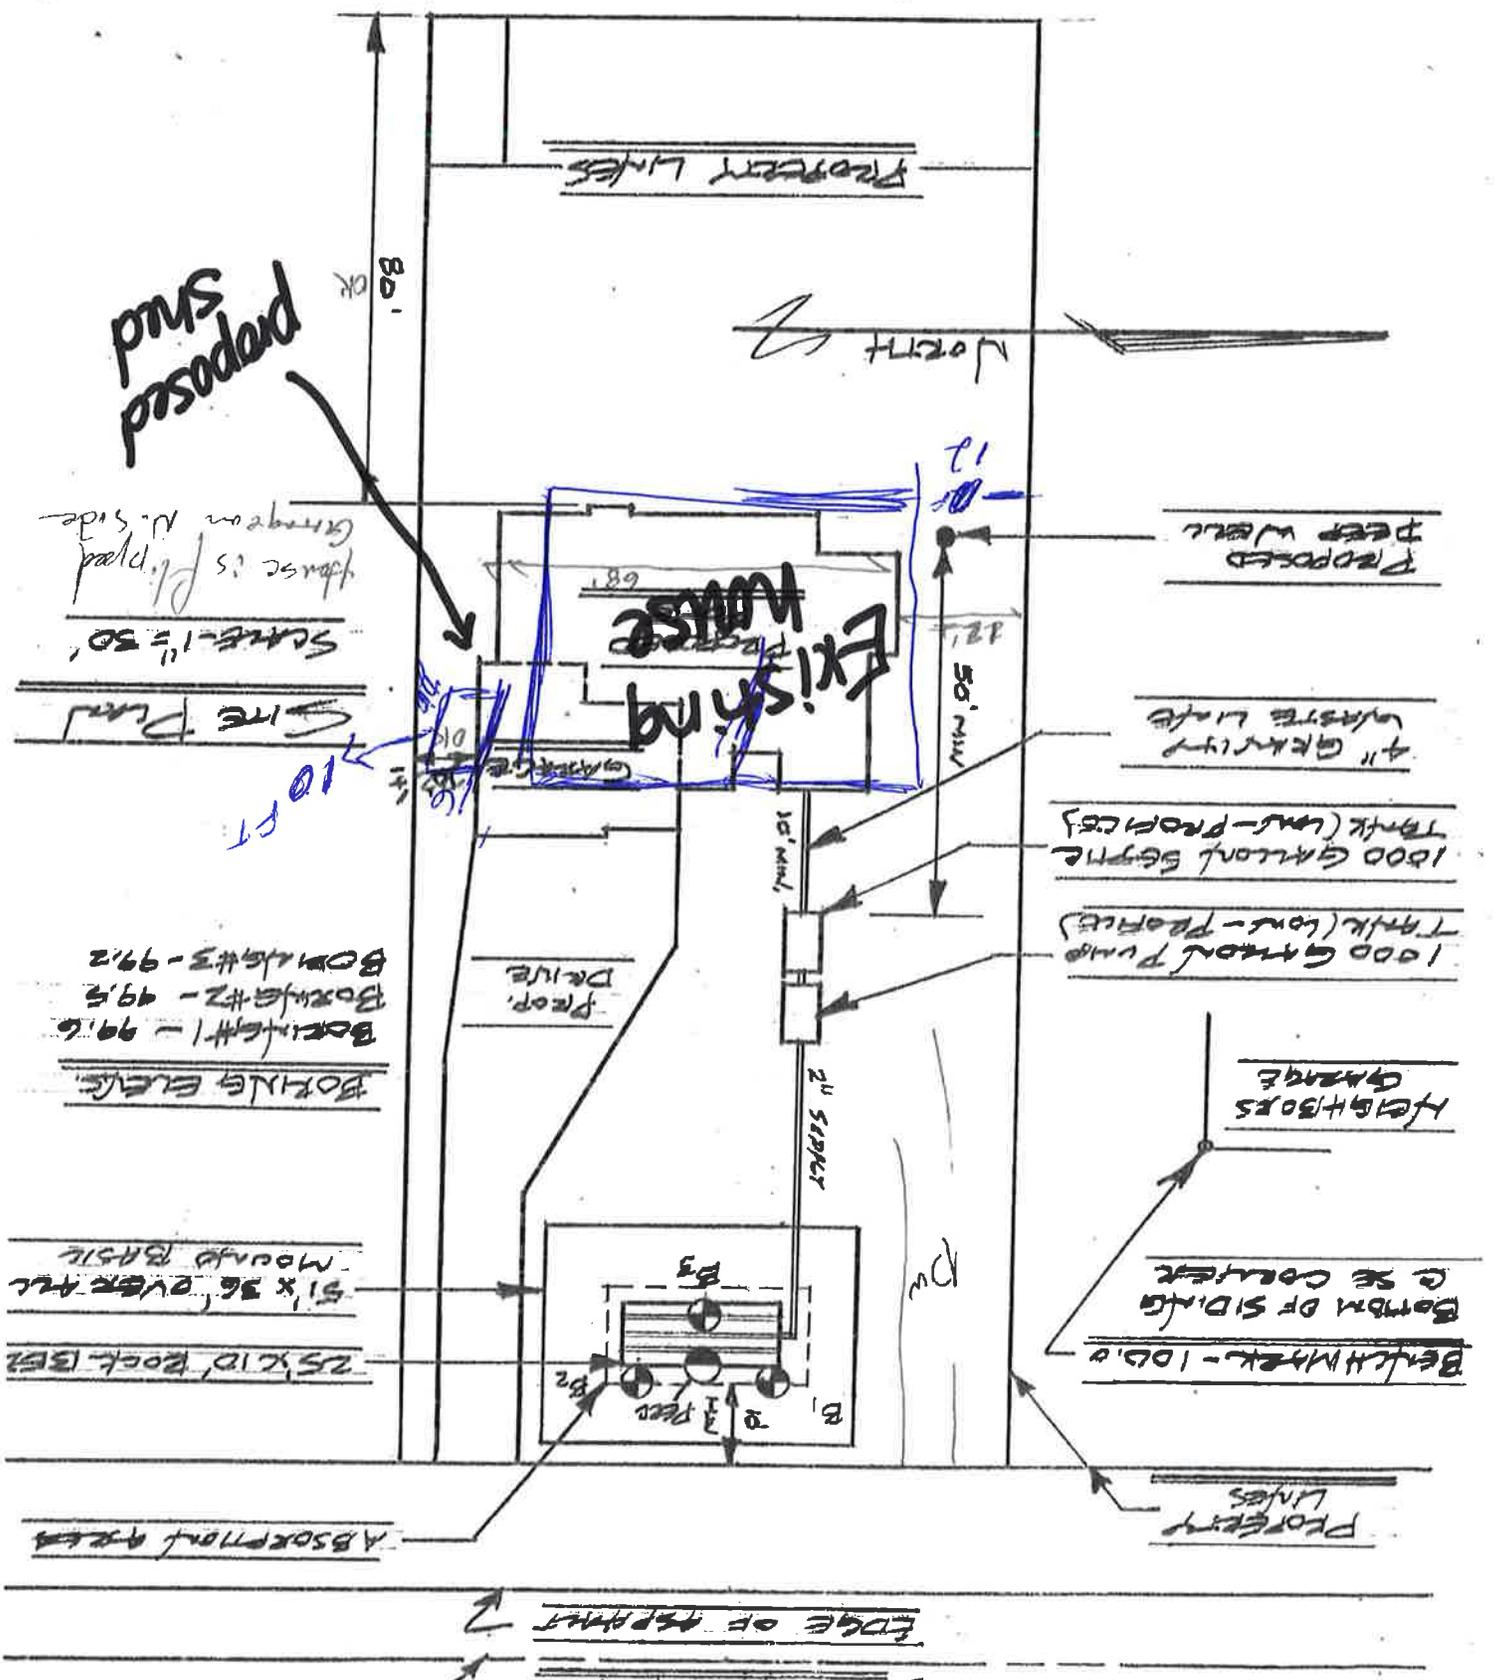

Proposed Shed

Existing House

House is Pl. prop. Green on N. side

Scale: 1" = 50'

Site Plan

BORING LOGS
Boring #1 - 99.6
Boring #2 - 99.5
Boring #3 - 99.2

51' x 36' OVER ALL
MOUND BASE
25' x 10' ROCK BED

ABSORPTION AREA

EDGE OF ASPHALT

NORTH

PROPOSED DEEP WELL

4" GREASY WASTE LINE

1500 GALLON SETTLE TANK (CON. - PROP.)

1000 GALLON PUMP TANK (CON. - PROP.)

HEIGHTS CHANGES

BOTTOM OF SIDING @ SE CORNER

BENCH MARK - 100.0

PROPERTY LINES

EDGE OF ASPHALT