

AITKIN COUNTY

CERTIFICATE OF COMPLIANCE/NOTICE OF NON-COMPLIANCE

This certificate of compliance/notice of non-compliance has been issued this 10th day of Sept 2013 to certify compliance/noncompliance with Aitkin County's Individual Sewage Treatment System and Wastewater Ordinance No. 1. The premises covered by this certificate are legally described as: lots 69+70 Bellhorn Heights

Section 17 Township 49 Range 23 Lake Back lot of Big
PERMIT No. 39756 Owner Name: Dale Burke Sandy
Address 21296 496th dn, McGregor, mn 55760
Installer Name ~~Dale Burke~~ Dale Sandberg
Type of System Inspected Mound
Parcel Number 29-1-336900

The ~~certificate of compliance~~ noncompliance was based on, No. 1 of the following: 1 Inspection of the installation or construction as in accordance with the above referenced permit and application design.

2) Review of as-built plans submitted in accordance with Subdivision 4.21 C. of Aitkin County's Individual Sewage Treatment System and Wastewater Ordinance No. 1.

If the above permitted individual sewage treatment system is in noncompliance with Aitkin County's Individual Sewage Treatment System and Wastewater Ordinance No. 1, then the following shall serve as a Notice of Violation:

1) Statement of the findings of fact through inspections or investigations:

2) List of specific violations of Ordinance: _____

3) Requirements for correction or removal of violations: _____

4) Time schedule for compliance: _____

Failure to correct or remove the above violation(s) will result in this matter being turned over to the Aitkin County Attorney's Office for further legal action which may result in revocation of licenses or registrations, fines and/or imprisonment.

INSPECTOR SIGNATURE: 

**INDIVIDUAL SEWAGE TREATMENT SYSTEM INSPECTION FORM
AITKIN COUNTY, MINNESOTA**

Township Shamrock Date of Inspection 9-9-13 Permit Number 39756
 Owner Dale Burke Parcel Number 29-1-336900
 Project Address lots 69+70 12 Bellhorn Heights Installer Dale Sandberg
 City _____ Zip Code _____

New Repair

SETBACKS:

Buildings to tank(s) 20'
 Buildings to drainfield 20'
 Well(s) 50' or 100' N/A
 Lake/Creek/Wetland Back lot

SEPTIC TANKS:

Number of tanks installed 1-Combo
 Liquid capacity and type Two precast 1650
 Type of baffle plastic
 Inspection pipes -
 Manholes size 3-24"
 Manhole to grade Yes No

PUMPS:

Tank capacity and type 650
 Pump manufacturer & model # Gould
 Horsepower & GPM 1/2-50
 Feet of head 12
 Gallons per cycle 100
 Size of discharge line 2"
 Type & location of alarm outdoor elec
 Water meter _____

DIST. or DROP BOX & TYPE _____


TRENCHES, BEDS, OR GRAVELLESS LEACHFIELD:

Trench depth _____
 Trench length _____
 Trench bottom width _____
 Trench spacing _____
 Drainfield rock below pipe _____
 Size of gravelless pipe _____
 Depth of backfill _____
 Absorption area: square feet _____
 lineal feet _____

MOUNDS:

Percent slope 10
 Upslope dike width 12'
 Downslope dike width 16'
 Sideslope dike width 12
 Drainfield rock below pipe 9"
 Depth of sand below rock 24"
 Perforation size & spacing 1/4-3'
 Pipe size & spacing 3-1/2 laterals
 Dimensions of rock bed 10x38
 Dimensions of sand base 38x67
 Final cover 16" in Center 12" on Rock Edge

DRAWING OF SYSTEM: (include soils)

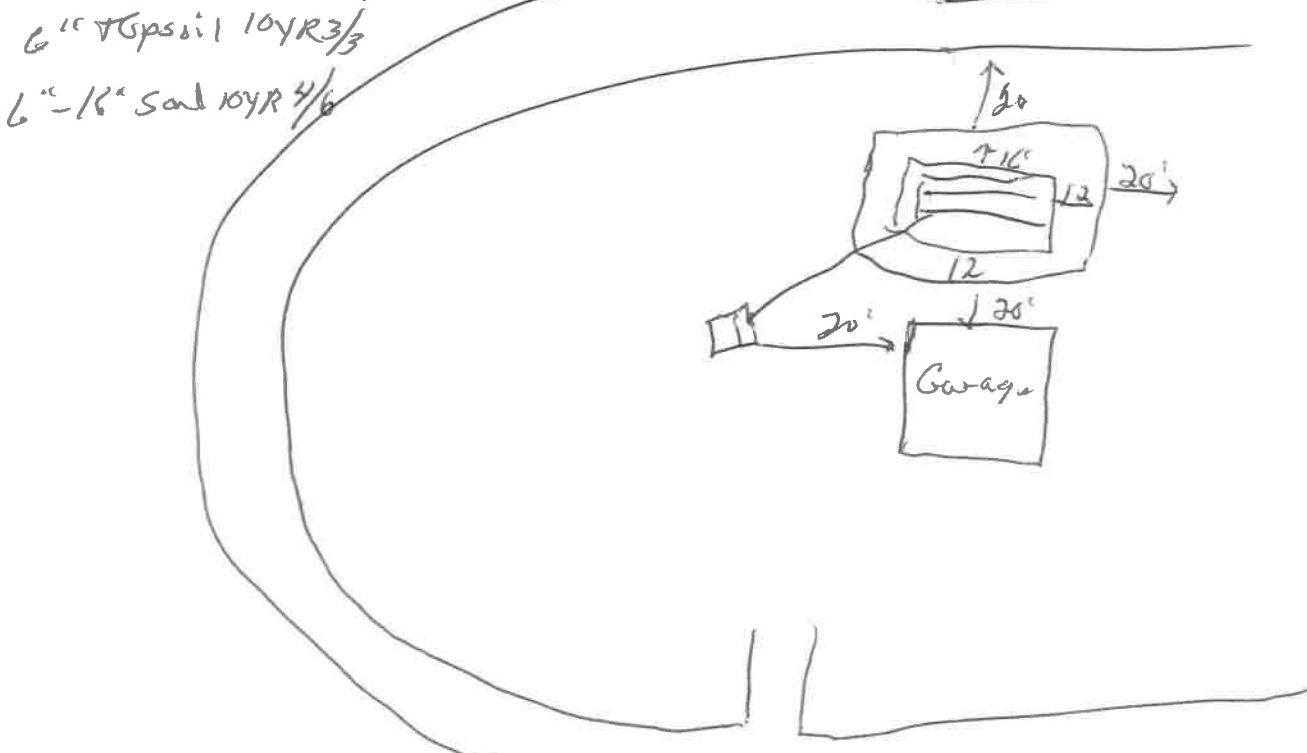

Inspector's Comments: _____

Inspector's Signature [Signature] Installer's Signature _____