


32759 387th PI

~~000000~~

24-0-015302

AITKIN COUNTY BUILDING PERMIT SITE PLAN

Please indicate the location of: Wells, well setback to system components, buildings, septic system components, reserved septic system area, property lines, waterways, and buried lines. Include size, length, and appropriate distances from fixed reference points. Provide a North directional arrow!

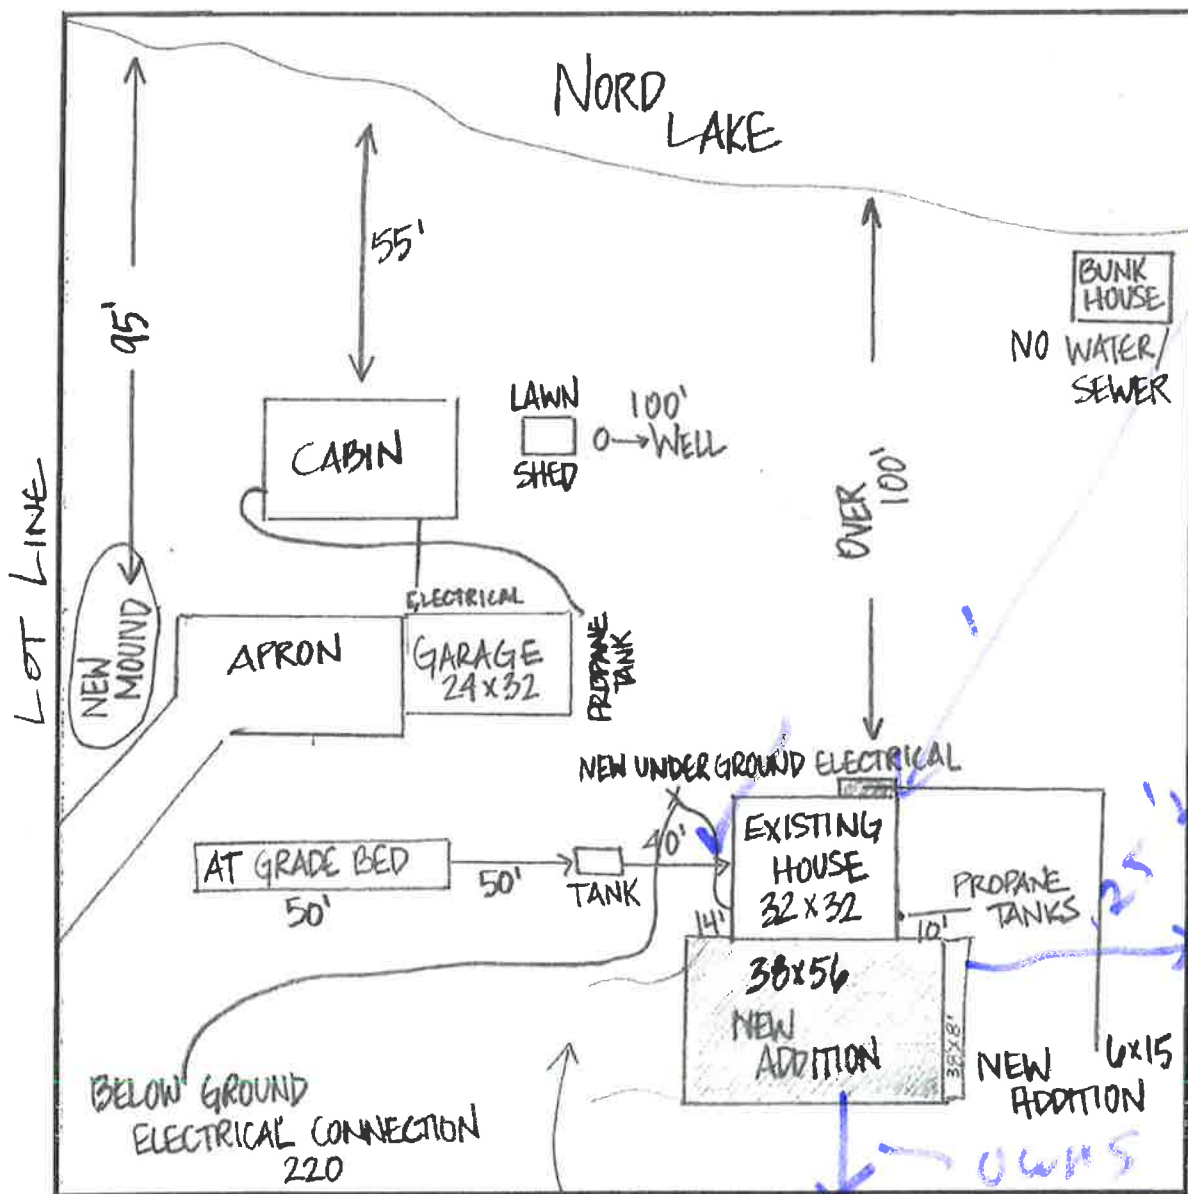

130' +

2128
 304

 2432
 90

 2522

owns property to south

block retaining wall