


### SKETCH SHEET & SOIL BORING LOG

Owner(s) Name: John S. & Linda L. Holmes

Parcel I.D. #: 07-1-103300

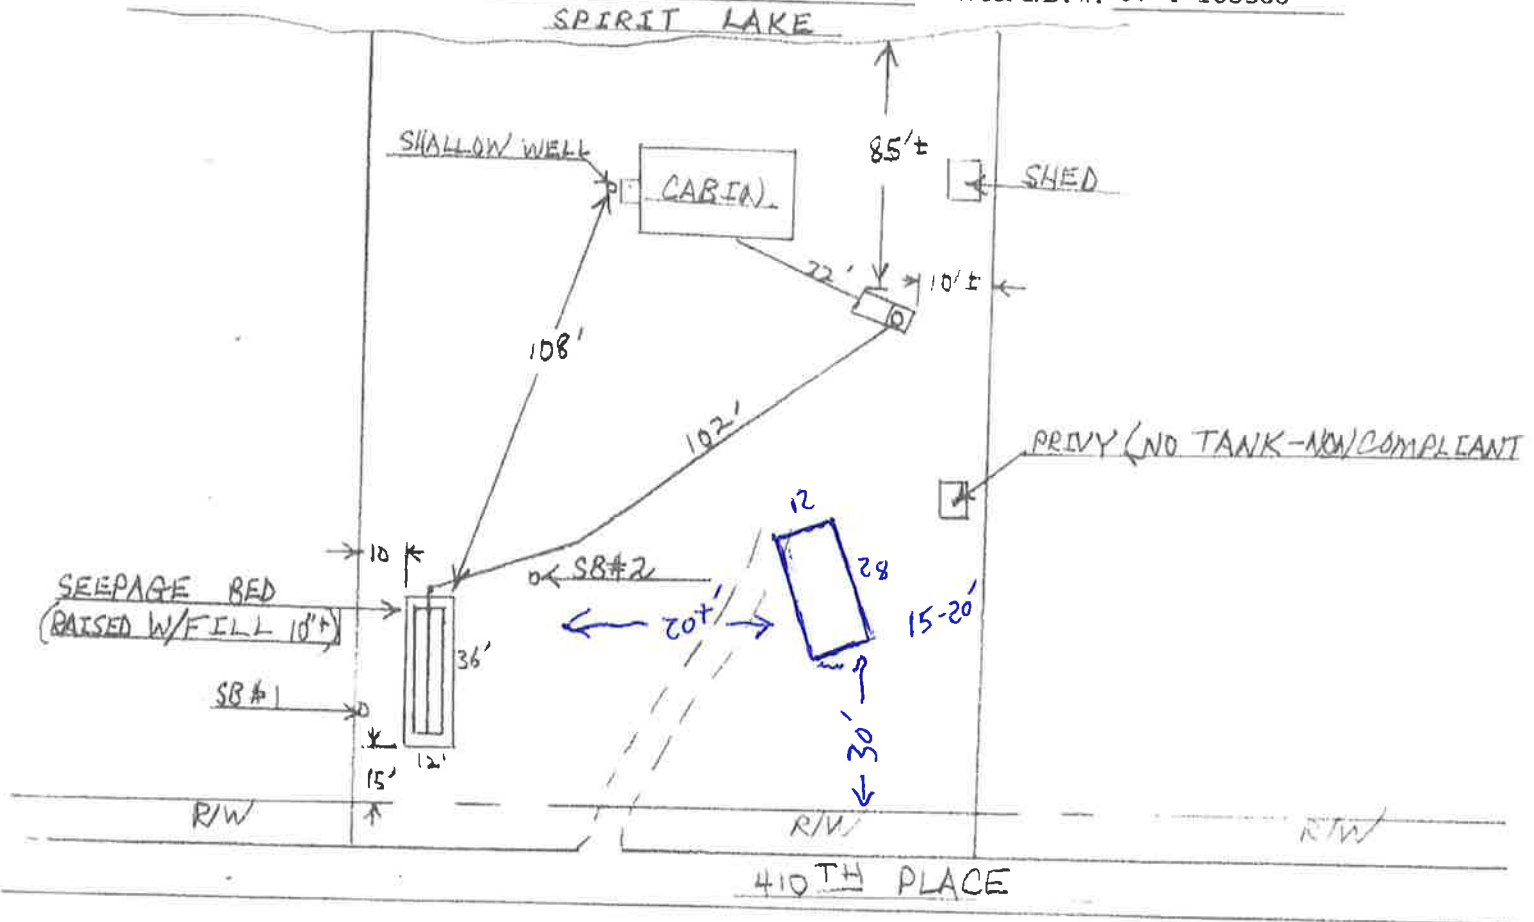

### SOIL BORING LOG

Soil Boring #1			Soil Boring #2		
Depth	Texture	Munsell Color	Depth	Texture	Munsell
0-5"	Topsoil		0-13"	Topsoil	
5"-21"	Loam(fill)	10YR4/4	13"-22"	Loam	10YR4/4
21"-32"	Topsoil	Black	22"-40"	Clay	10YR5/4
32"-48"	Clay	10YR5/4 & 5/2			& 5/2
Mottling @ 33"			Mottling @ 22"		

Charles J. Virginia Lic. #: L1392 Cert. #: C4023

Signature: Charles J. Virginia Date: August 30, 2012