

Iverson, Eugene
2470 Clearview Ave.
New Brighton, Mn. 55112

No. 8224
Vanduse Lake

Ball Bluff Twp.
10/30/80
R D

Lot 6 Blk. 1 Peacefil Pines Estate
22-52-23

P. # 02-1-079400

Cabin-?
26X30

Sewer-?
750 gal septic

2 bedrooms

Well-?

Inspection- DMF 2/15/83 Nothing Done see #9912

IVERSON, Eugene

2-794

Permit: 4771

12-13-77

Base Bluff

2470 Clearview Ave.

New Brighton

Tele: 784-4913

Lot 6 Block 1 22-52-23

Plat of Peaceful Pines Estate

Vanduse Lake


RD

P. # 02-1-079400

7x9 util. & outhouse - self

Inspection: 2-19-81 Omb

Installed well w/o permit
sent letter 2-23-81

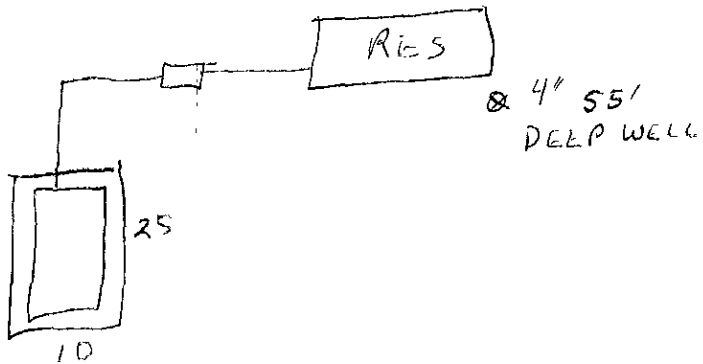

Eugene Iverson
2470 Clearview Ave.
St. Paul, Mn. 55112

No. 9912
VAnduse Lake

Ball Bluff Twp.
8/16/82
RD

Lot 6, Block 1, Peaceful Pines Estates
22-52-23

P. # 02-1-079400

22 x 32 Res: Self

Sewer: ? 5 perc, 2 bdrm., 250 field, 750 tank.

Inspection: DMF 9/7/82 Some clay in soil if field fills up may
have to add to field.

DMF 11/4/83