


PRELIM. 9-1-04
 REVISE 9-15-04
 FINAL 9-11-04


RESIDENCE FOR:
JIM & PAT GANS

1 / **8**

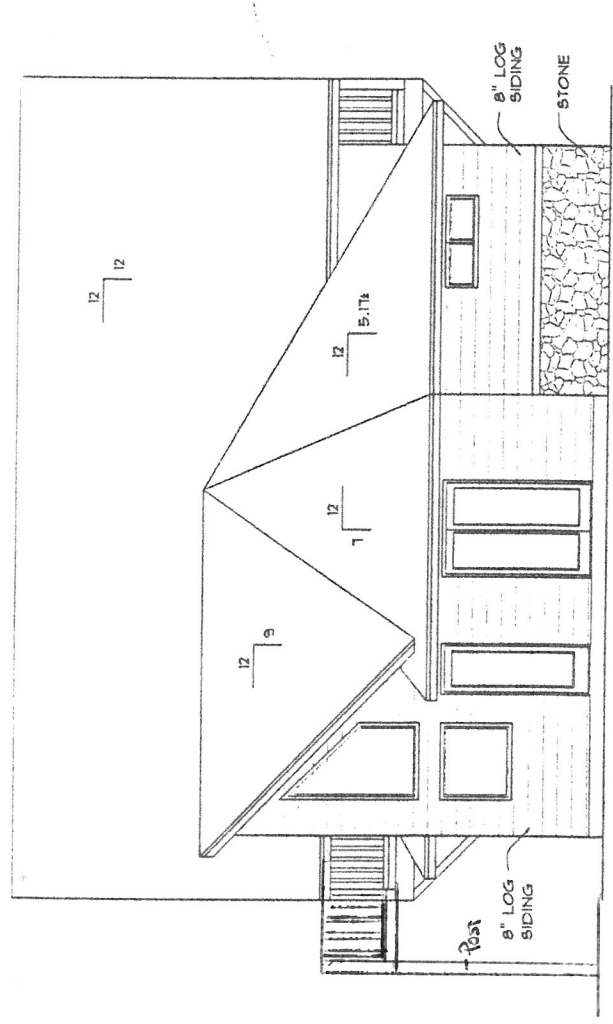

RIGHT ELEVATION 1/4" = 1'-0"

STRUCTURAL FOR
 BALCONY TO BE
 VERIFIED BY OWNER

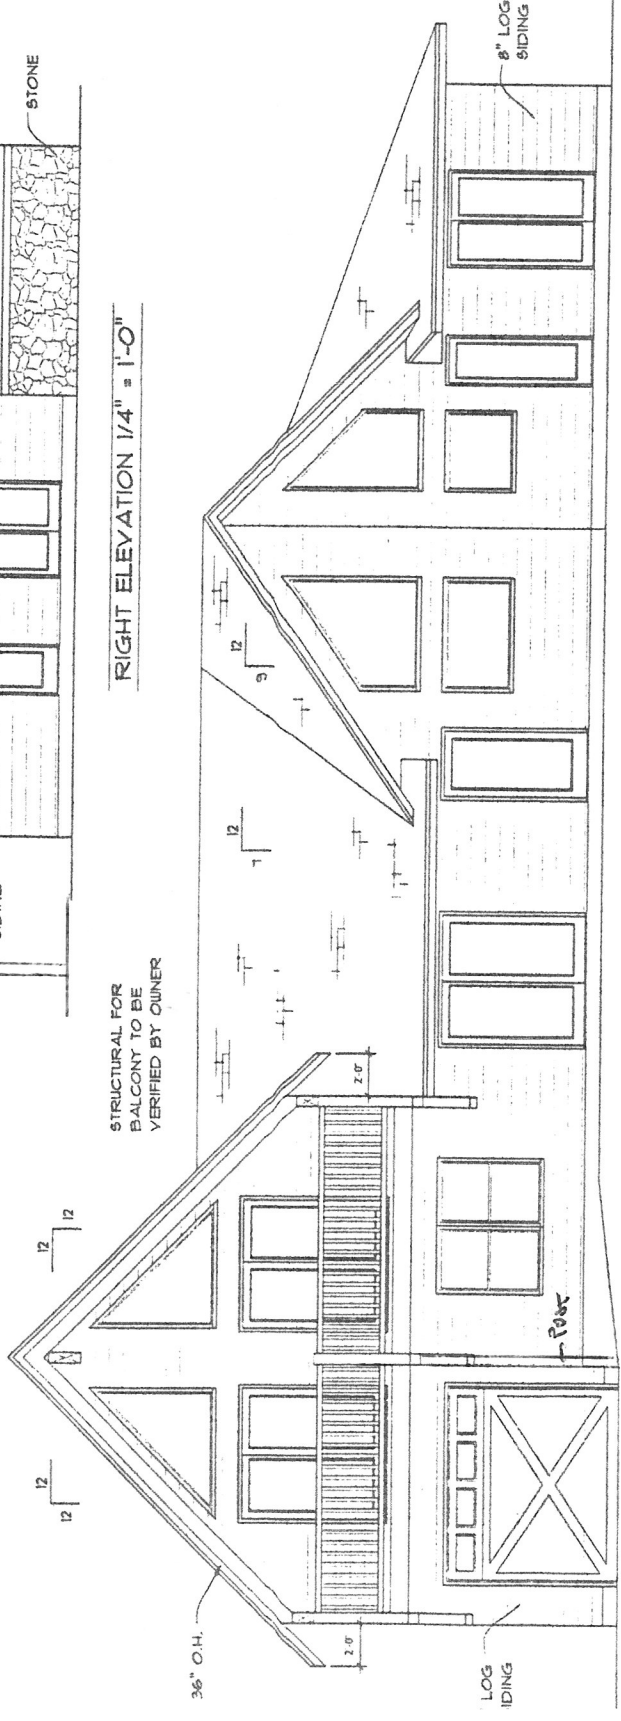


LAKE SIDE ELEVATION 1/4" = 1'-0"


ICF FOUNDATION
 8' CEILING @ FIRST FLOOR
 IN-FLOOR-HEAT

*ALL DOOR & WINDOW HEADERS
 TO BE S.P.F. #2 OR BETTER
 *HOUSE TO BE BUILT TO
 I.P.C. STANDARDS


1st FLR. 1,436 SQ. FT.
 2nd FLR. 784 SQ. FT.
 TOTAL 2,220 SQ. FT.

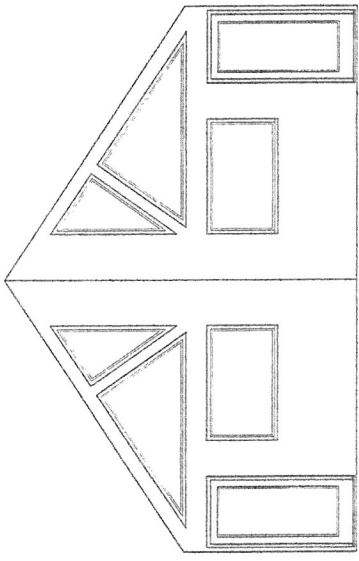


OPTIONAL WINDOW CONFIGURATION • GREAT ROOM

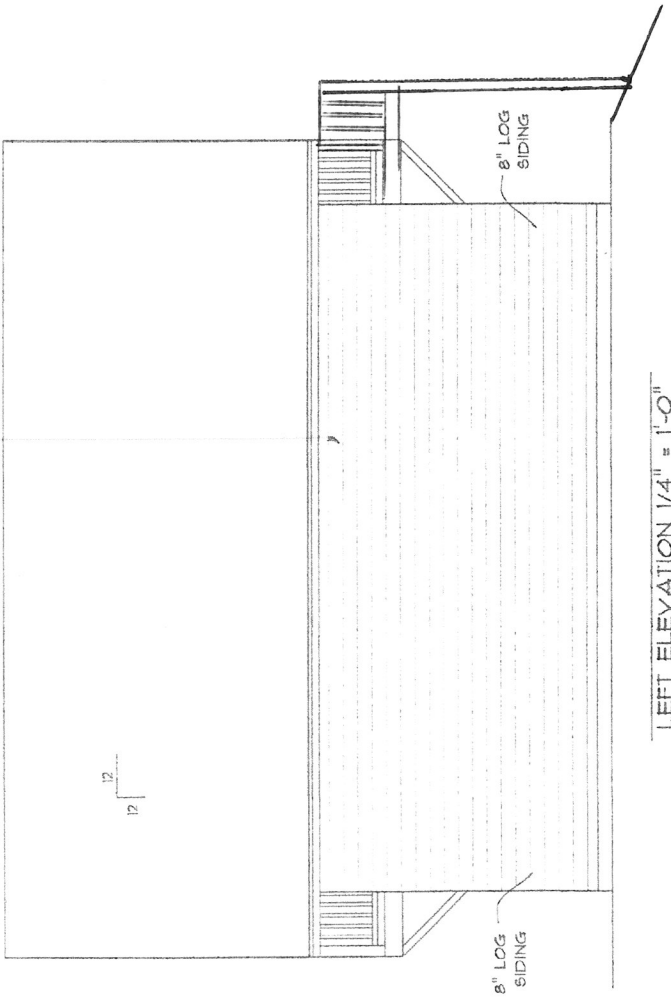

LEFT ELEVATION 1/4" = 1'-0"

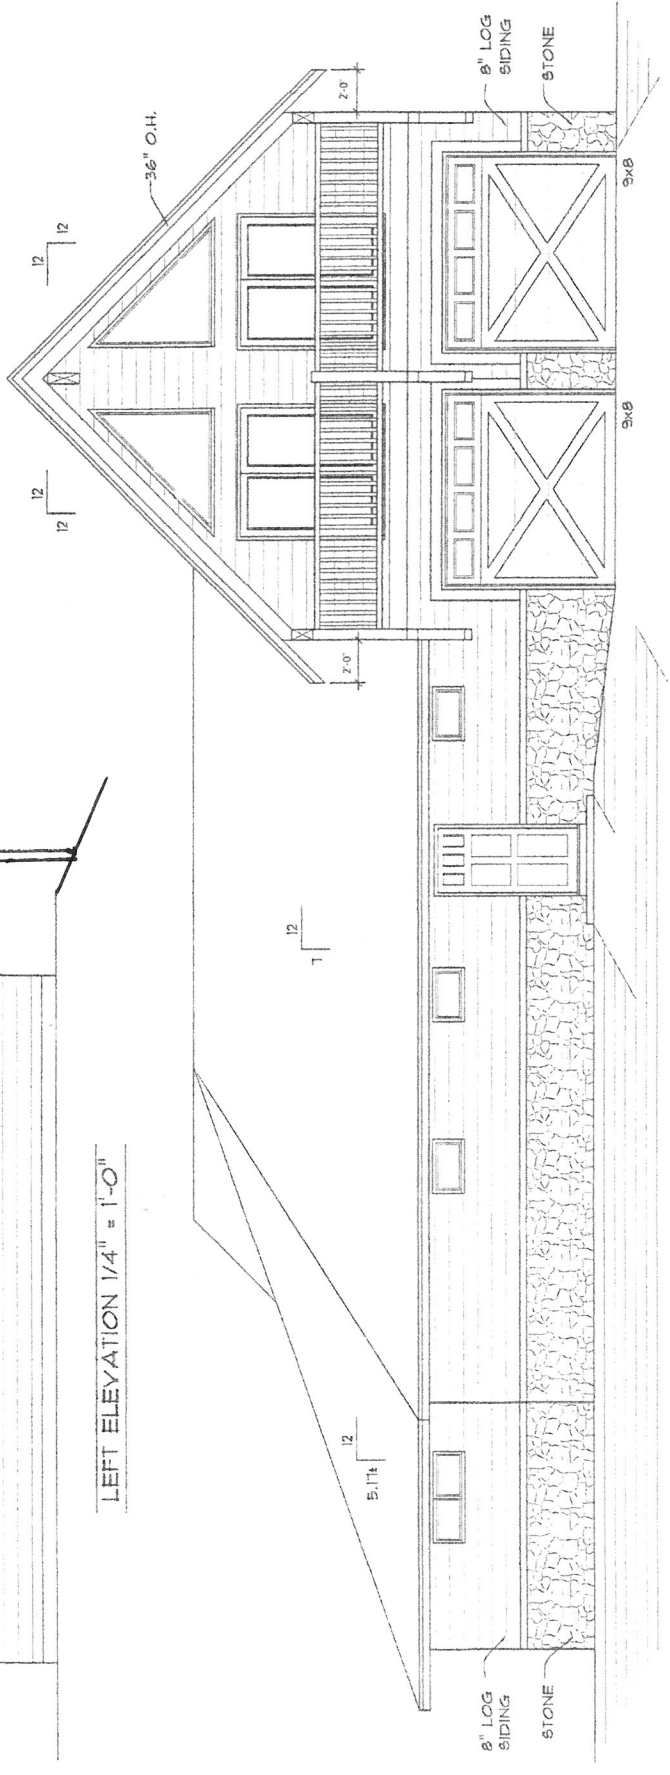

ROAD SIDE ELEVATION 1/4" = 1'-0"

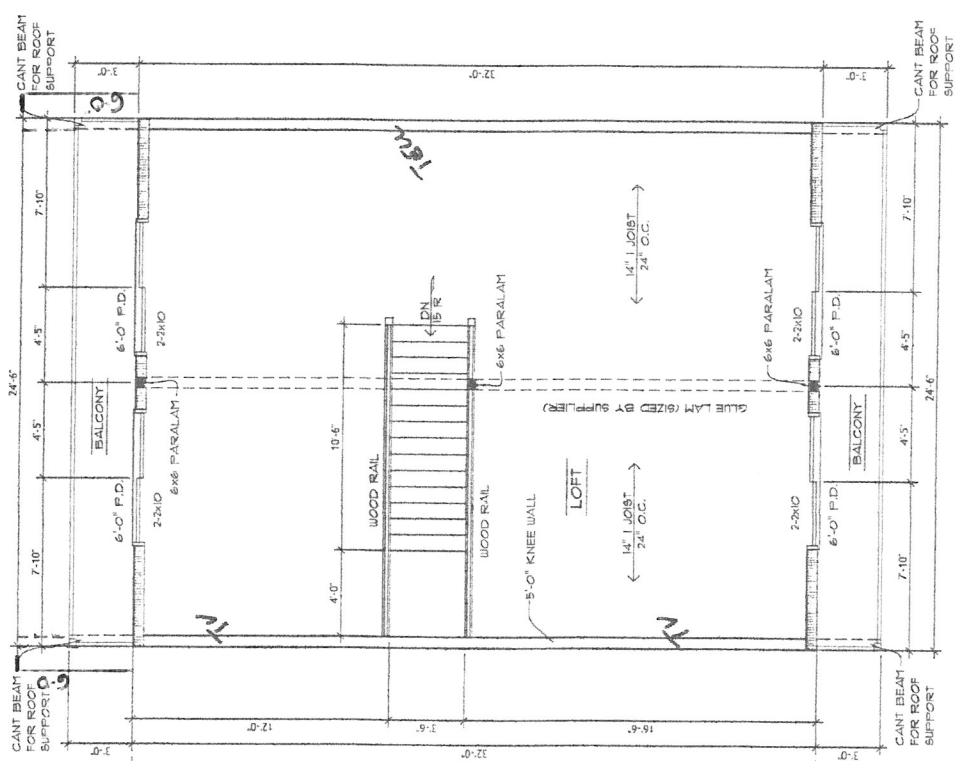

SECOND FLOOR PLAN 1/4" = 1'-0"
184 SQ. FT.