


GREG SATERDALEN
 CELL# 612-430-3532

41440 290TH ST.
 AITKIN, MN 56431

CERTIFICATE OF SURVEY
 OF PART OF GOVT. LOT 7,
 SEC. 26. TWP. 46, RNG. 27,
 AITKIN COUNTY, MINNESOTA

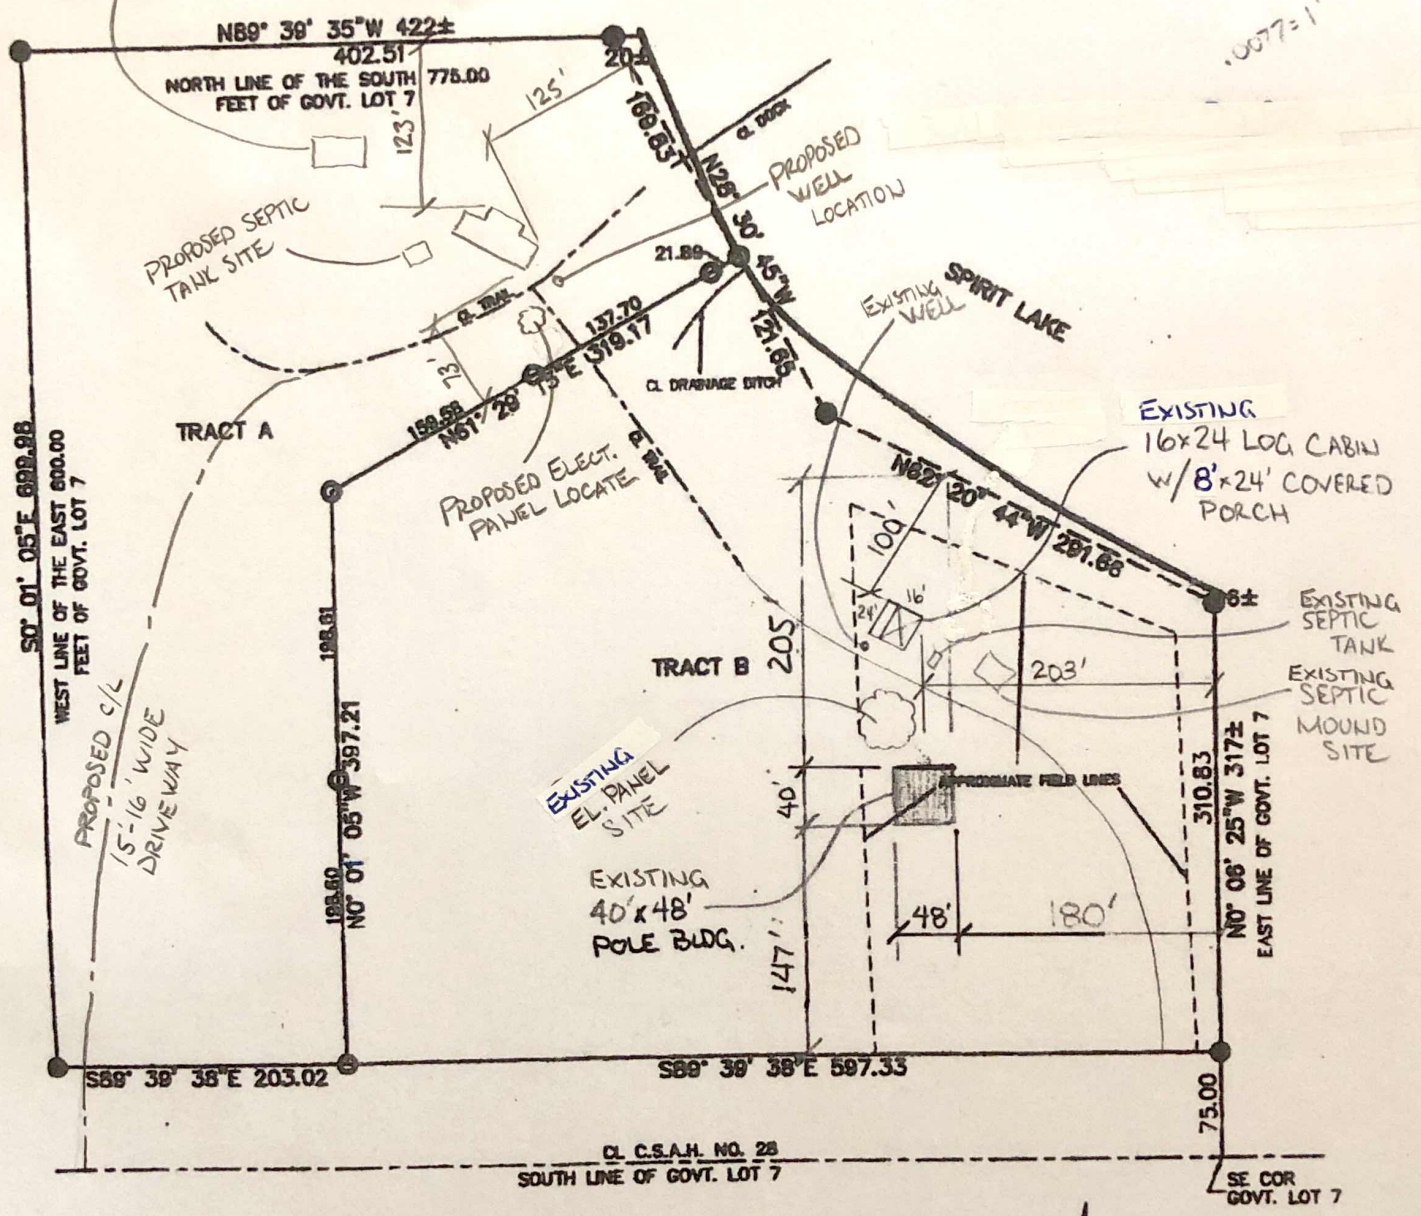

MARVIN KOHOUT
 LICENSED LAND SURVEYOR
 PO BOX 384
 AITKIN, MN 56431-0384
 218-927-5452

I HEREBY CERTIFY THAT THIS SURVEY PLAN OR REPORT WAS
 PREPARED BY ME OR UNDER MY DIRECT SUPERVISION AND
 THAT I AM A DULY LICENSED LAND SURVEYOR UNDER THE
 LAWS OF THE STATE OF MINNESOTA.

DATE _____ LIC. NO. 17774

- FOUND IRON MONUMENT
 - SET 3/8" REBAR W/ RLS CAP 17774
- BEARING DATUM IS BASED ON AITKIN
 COUNTY COORDINATE SYSTEM

