

Compliance Inspection Form

507-380-6206

Regulatory authority phone: 218-927-7342

Existing Subsurface Sewage Treatment Systems (SSTS)

Doc Type: Compliance and Enforcement

| Inspection results based on Minnesota Pollution Control Agency (MPCA) requirements and attached forms – additional local requirements may also apply. | For local tracking purposes: | | |
|--|---|--|--|
| Submit completed form to Local Unit of Government (LUG) and system owner within 15 days | | | |
| System Status | | | |
| System status on date (mm/dd/yyyy): 6/13/2018 | | | |
| | oliant – Notice of Noncompliance le Requirements on page 3.) | | |
| Reason(s) for noncompliance (check all applicable) | | | |
| Impact on Public Health (Compliance Component #1) – Imminent threat to | o public health and safety | | |
| Other Compliance Conditions (Compliance Component #3) – Imminent th | reat to public health and safety | | |
| ☐ Tank Integrity (Compliance Component #2) — Failing to protect groundwa | ter | | |
| Other Compliance Conditions (Compliance Component #3) – Failing to pr | rotect groundwater | | |
| ☐ Soil Separation (Compliance Component #4) – Failing to protect groundw ☐ Operating permit/monitoring plan requirements (Compliance Component) | vater | | |
| | #5) — Noncompliant | | |
| Property Information Property address: 24037 435 th AveAitkin, MN. 56431 Reason | | | |
| Reason | for inspection: property transfer | | |

Certification

Owner's representative:

Local regulatory authority:

Brief system description:

Property owner: Matt Margenthaler

Comments or recommendations:

or

I hereby certify that all the necessary information has been gathered to determine the compliance status of this system. No determination of future system performance has been nor can be made due to unknown conditions during system construction, possible abuse of the system, inadequate maintenance, or future water usage.

| Inspector name: | Tim Woodrow | Certification number: | C7644 |
|-------------------|-----------------------------|-----------------------|-----------|
| Business name: | Goble's Sewer Service, Inc. | License number: | L455 |
| Inspector signatu | re: | Phone number: | NOT STORY |

Necessary or Locally Required Attachments

| ☐ Soil boring logs | ☐ System/As-built drawing | |
|---------------------------|---------------------------|--|
| Other information (list): | Tank pumping report | |

Aitkin Co.

1500 gal. pre-cast concrete "Holding Tank"

☐ Forms per local ordinance

Owner's phone:

Representative phone:

| Pro | perty address: 24037 435th AveAit | kin, MN. 56431 | Inspector initials/Date: 6/14/2018 | | | | |
|-----------|---|----------------------------|--|--|--|--|--|
| | | | (mm/dd/yyyy) | | | | |
| 1. | Impact on Public Health - (| Compliance compon | ent #1 of 5 | | | | |
| | Compliance criteria: | | Verification method(s): | | | | |
| | System discharges sewage to the ground surface. System discharges sewage to drain tile or surface waters. System causes sewage backup into dwelling or establishment. Any "yes" answer above indisystem is an imminent threathealth and safety. Comments/Explanation: Tank Integrity — Compliance Compliance criteria: System consists of a seepage pit, cesspool, drywell, or leaching pit. Seepage pits meeting 7080.2550 may be compliant if allowed in local ordinance. Sewage tank(s) leak below their designed operating depth. If yes, which sewage tank(s) leaks: Any "yes" answer above indisystem is failing to protect git Comments/Explanation: Other Compliance Condition a. Maintenance hole covers are dama b. Other issues (electrical hazards, etc.) | ☐ Yes ☒ No | ⊠ Searched for surface outlet | | | | |
| | System discharges sewage to drain | ☐ Yes ☒ No | ☑ Searched for seeping in yard/backup in home ☑ Excessive ponding in soil system/D-boxes | | | | |
| | System causes sewage backup into dwelling or establishment. | ☐ Yes ☒ No | ☐ Homeowner testimony (See Comments/Explanation) ☐ "Black soil" above soil dispersal system | | | | |
| | Any "yes" answer above indesystem is an imminent threat health and safety. | | ☐ System requires "emergency" pumping ☐ Performed dye test ☐ Unable to verify (See Comments/Explanation) ☐ Other methods not listed (See Comments (See Comments)) | | | | |
| | | tin Mil Seatt | ☐ Other methods not listed (See Comments/Explanation) | | | | |
| | | | | | | | |
| | | | | | | | |
| | | | | | | | |
| | | component #2 of 5 | | | | | |
| Sh | Compliance criteria: | F BYE DW | Verification method(s): | | | | |
| | System consists of a seepage pit, | ☐ Yes ⊠ No | ☐ Probed tank(s) bottom | | | | |
| Fo | Seepage pits meeting 7080.2550 may be | □ D Yes □ No | ☐ Examined construction records☐ Examined Tank Integrity Form (Attach) | | | | |
| | Sewage tank(s) leak below their designed operating depth. | ☐ Yes ⊠ No | ☐ Observed liquid level below operating depth ☑ Examined empty (pumped) tanks(s) ☐ Probed outside tank(s) for "black soil" | | | | |
| sel No | Any "yes" answer above indi | | ☐ Unable to verify (See Comments/Explanation) ☐ Other methods not listed (See Comments/Explanation) | | | | |
| | Comments/Explanation: | | | | | | |
| sys | | | APPENDING TO SECOND TO SEC | | | | |
| | | to immediately and adver | or appear to be structurally unsound. Yes* No Unknowsely impact public health or safety. | | | | |
| | Explain: | public fleatur and Safet | 5. Periodically scrutates actification | | | | |
| | erafidm destance wars bereathcasty nated and or highwork | | | | | | |
| | c. System is non-protective of ground *System is failing to protect grou | water for other conditions | as determined by inspector . Yes* No | | | | |
| | | | | | | | |

Goble's Sewer Service inc.

1037 1st Street NW
Aitkin, MN 56431 License # 455
927-6175 800-713-5234
MPCA registered company

Septic tank fact sheet:

Tim Woodrow

System inspector or installer

Current septic tank owner: Matt Margenthaler

Site address:

24037 435th Ave

Aitkin MN 56431

Phone number:

Beth - 612-390-1386 (Realtor)

Tank type:

Precast Concrete

Approx. size (gallons):

1500

Approx. age:

Lift station (how many):

1300

Our procedure for inspecting a septic tank is as follows.

Open the access cover.

Clean the septic and lift tanks removing all of the solid and liquid waste.

Do a fresh water rinse (not available during cold winter months).

Look at the septic & or lift tank from the access opening looking for cracks, breaks or other signs of deterioration.

Check to see if the baffles are still functional.

Replace the access cover.

Defects are listed below:

NONE

Recommendations or comments:

Tank is ok and does not appear to leak.

Observed by:

Observation date:

Craig Perlberg(Jeremy Goble)

June 7, 2018

Note: This tank appears water tight within the normal operating range of the tank, there are no guarantees that it will keep ground water out.


Note: This is a septic tank fact sheet, not a complete sewer system inspection form and does not replace a complete sewer inspection for transfer of property. In some instances, this form may be used in conjunction with a sewer inspection.

SKETCH SHEET AND SOIL BORING LOG

INSPECTOR: The Weeken

PID#: (1-1-047000)

24037 435th AK

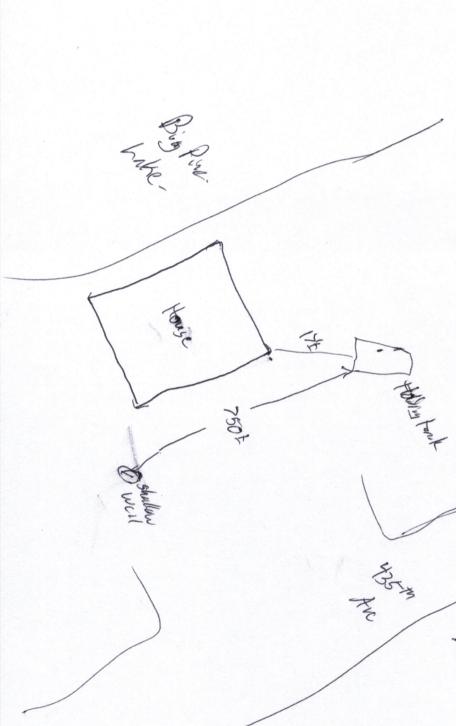

| | | | DEPTH | |
|--|--|--|---------|----------------|
| | | | TEXTURE | SOIL BORING #1 |
| | | | COLOR | |

| | | | DEPTH | | |
|--|--|--|---------|----------------|--|
| | | | TEXTURE | SOIL BORING #2 | |
| | | | COLOR | | |