


Lake

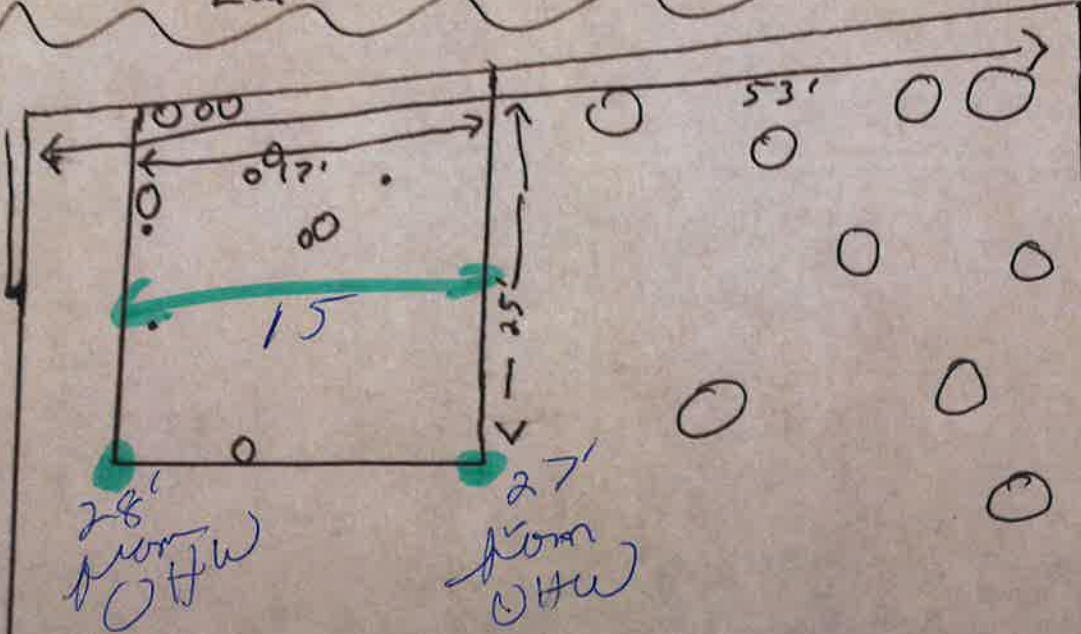

New driveway