



Minnesota Pollution Control Agency
520 Lafayette Road North
St. Paul, MN 55155-4194

Compliance Inspection Form

Existing Subsurface Sewage Treatment Systems (SSTS)

Doc Type: Compliance and Enforcement

Inspection results based on Minnesota Pollution Control Agency (MPCA) requirements and attached forms – additional local requirements may also apply.
Submit completed form to Local Unit of Government (LUG) and system owner within 15 days

For local tracking purposes:

System Status

System status on date (m/d/yyyy): 6/27/2016

Compliant – Certificate of Compliance (Valid for 3 years from report date, unless shorter time frame outlined in Local Ordinance.)
 Noncompliant – Notice of Noncompliance (See Upgrade Requirements on page 3.)

Reason(s) for noncompliance (check all applicable)

- Impact on Public Health (Compliance Component #1) – Imminent threat to public health and safety
- Other Compliance Conditions (Compliance Component #3) – Imminent threat to public health and safety
- Tank Integrity (Compliance Component #2) – Failing to protect groundwater
- Other Compliance Conditions (Compliance Component #3) – Failing to protect groundwater
- Soil Separation (Compliance Component #4) – Failing to protect groundwater
- Operating permit/monitoring plan requirements (Compliance Component #5) – Noncompliant

Property Information

Parcel ID# or Sec/Twp/Range: 14-0-054502
 Property address: 26205 st. hwy. 210, McGregor, Mn. 55760
 Reason for inspection: Transfer of property

Property owner: Jerome & Aileen Demenge
 Owner's phone: _____

Owner's representative: _____
 Local regulatory authority: Aitkin Co. P&Z
 Regulatory authority phone: 218-927-7342

Brief system description: 1350 gal. septic tank that gravity feeds into a 14' x 32' drainfield.

Comments or recommendations:

Certification

I hereby certify that all the necessary information has been gathered to determine the compliance status of this system. No determination of future system performance has been nor can be made due to unknown conditions during system construction, possible abuse of the system, inadequate maintenance, or future water usage.

Inspector name: Jarold R. Farley
 Business name: Farley Sewer Systems

Inspector signature:
 License number: 1919
 Phone number: 218-839-4737

Soil boring logs
 System/As-built drawing
 Forms per local ordinance

Other information (list): _____

1. Impact on Public Health – Compliance component #1 of 5

Compliance criteria:

| | |
|---|---|
| <input type="checkbox"/> Yes <input checked="" type="checkbox"/> No | System discharges sewage to the ground surface. |
| <input type="checkbox"/> Yes <input checked="" type="checkbox"/> No | System discharges sewage to drain tile or surface waters. |
| <input type="checkbox"/> Yes <input checked="" type="checkbox"/> No | System causes sewage backup into dwelling or establishment. |

Any "yes" answer above indicates the system is an imminent threat to public health and safety.

Comments/Explanation:

Property address: 26205 st. hwy. 210, McGregor, Mn. 55760

Inspector initials/Date: TRF 6/27/2016 (mm/dd/yyyy)

Verification method(s):

- Searched for surface outlet
- Searched for seeping in yard/backup in home
- Excessive ponding in soil system/D-boxes
- Homeowner testimony (See Comments/Explanation)
- "Black soil" above soil dispersal system
- System requires "emergency" pumping
- Performed dye test
- Unable to verify (See Comments/Explanation)
- Other methods not listed (See Comments/Explanation)

2. Tank Integrity – Compliance component #2 of 5

Compliance criteria:

| | |
|---|--|
| <input type="checkbox"/> Yes <input checked="" type="checkbox"/> No | System consists of a seepage pit, cesspool, drywell, or leaching pit. Seepage pits meeting 7080.2550 may be compliant if allowed in local ordinance. |
| <input type="checkbox"/> Yes <input checked="" type="checkbox"/> No | Seepage tank(s) leak below their designed operating depth. If yes, which sewage tank(s) leaks: |

Any "yes" answer above indicates the system is failing to protect groundwater.

Comments/Explanation:

Tank pumped by globe sewer service

Verification method(s):

- Probed tank(s) bottom
- Examined construction records
- Examined Tank Integrity Form (Attach)
- Observed liquid level below operating depth
- Examined empty (pumped) tanks(s)
- Probed outside tank(s) for "black soil"
- Unable to verify (See Comments/Explanation)
- Other methods not listed (See Comments/Explanation)

3. Other Compliance Conditions – Compliance component #3 of 5

a. Maintenance hole covers are damaged, cracked, unsecured, or appear to be structurally unsound. Yes* No Unknown

b. Other issues (electrical hazards, etc.) to immediately and adversely impact public health or safety. Yes* No Unknown

System is an imminent threat to public health and safety.

Explain:

c. System is non-protective of ground water for other conditions as determined by inspector. Yes* No

System is failing to protect groundwater.

Explain:

Upgrade Requirements (Minn. Stat. § 115.55) An imminent threat to public health and safety (TPHS) must be upgraded, replaced, or its use discontinued within ten months of receipt of this notice or within a shorter period if required by local ordinance. If the system is failing to protect groundwater, the system must be upgraded, replaced, or its use discontinued within the time required by local ordinance. If an existing system is not falling as defined in law, and has at least two feet of design soil separation, then the system need not be upgraded, repaired, replaced, or its use discontinued, notwithstanding any local ordinance that is more strict. This provision does not apply to systems in shoreland areas, Wellhead Protection Areas, or those used in connection with food, beverage, and lodging establishments as defined in law.

Any "no" answer indicates Noncompliance.

a. Operating Permit number: _____
 Have the Operating Permit requirements been met? Yes No

b. Is the required nitrogen BMP in place and properly functioning?
 Yes No

Compliance criteria

If the answer to both questions is "no", this section does not need to be completed.

BMP = Best Management Practice(s) specified in the system design

Is the system operated under an Operating Permit? Yes No If "yes", A below is required

Is the system required to employ a Nitrogen BMP? Yes No If "yes", B below is required

5. Operating Permit and Nitrogen BMP* – Compliance component #5 of 5 Not applicable

Any "no" answer above indicates the system is failing to protect groundwater.

| | |
|--|-----|
| A. Bottom of distribution media | 97" |
| B. Periodically saturated soil/bedrock | 94" |
| C. System separation | 36" |
| D. Required compliance separation* | 36" |

*May be reduced up to 15 percent if allowed by Local Ordinance.

Indicate depths or elevations

For systems built prior to April 1, 1996, and not located in Shoreland or Wellhead Protection Area or not serving a food, beverage or lodging establishment: Yes No

Non-performance systems built April 1, 1996, or later or for non-performance systems located in Shoreland or Wellhead Protection Areas or serving a food, beverage, or lodging establishment: Yes No

Drainfield has a three-foot vertical separation distance from periodically saturated soil or bedrock.* Yes No

Drainfield meets the designed vertical separation distance from periodically saturated soil or bedrock. Yes No

Compliance criteria:

Shoreland/Wellhead protection/food beverage lodging? Yes No

Date of installation: 5/23/1978 Unknown (m/d/yyyy)

Verification method(s): _____

Soil observation does not expire. Previous soil observations by two independent parties are sufficient, unless site conditions have been altered or local requirements differ.

Conducted soil observation(s) (Attach boring logs)

Two previous verifications (Attach boring logs)

Not applicable (Holding tank(s), no drainfield)


Unable to verify (See Comments/Explanation)

Other (See Comments/Explanation)

Comments/Explanation:

0-6" top soil 10 yr 3/2
 6-48" med sand 10 yr 4/6
 48-74" med. sand 10 yr 4/4
 no mottles at 74"

4. Soil Separation – Compliance component #4 of 5

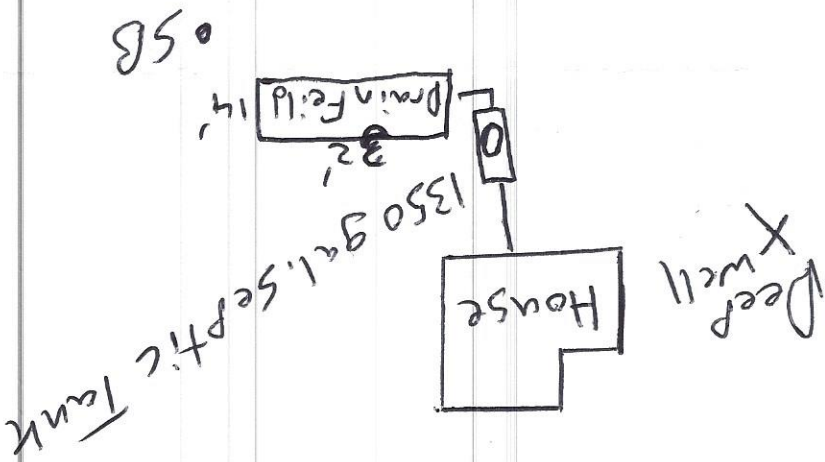

State Hwy. 210

FARLEY SEWER SYSTEMS

P.O. Box 472
McGregor, MN 55760

Bus. Lic. No. L1919
Reg. No. 4744
218-839-4737 cell

JAROLD R. FARLEY

SEWER DESIGN & INSTALLATION