



Minnesota Pollution Control Agency

520 Lafayette Road North
St. Paul, MN 55155-4194

SSTS Abandonment Reporting Form

Subsurface Sewage Treatment Systems (SSTS) Program

Instructions

This form is offered to meet the abandonment requirements of Minn. R. 7080.2500 and Disclosure Requirements of Minn. Stat. § 115.55, subd. 6. Future water supply well placement can also be affected by an abandoned SSTS.

The use of this form is not mandatory; however the information on this form must be submitted to the local government unit (LGU) within 90 days after the abandonment. This form may be completed by a certified SSTS practitioner or by an individual who has direct knowledge of how the system was abandoned.

Property Information

Date of abandonment: 7-8-19 Reason for abandonment: Noncompliant system - abandoned to obtain building permit. Replaced w/ composting toilet

Property owner name(s): Greg & Rebecca Hansen

Property owner's address: 5347 EVAN RD

City: DUCATH State: MN Zip: 55804

Site address (if different): Fire # 27234 Atkinson Co. # 18

City: PAUSADE (LIBBY TWP) State: MN Zip: _____

Compliance Information


- All solids and liquids removed from all tanks? Yes No NA
Disposal Site: _____
- All electrical devices and devices containing mercury removed? Yes No NA
Disposal Site: _____
- All underground sewage tanks crushed and filled with soil or rock material? Yes No or NA
Removed and disposed off site? Yes No
Disposal Site: _____
- Contaminated materials* removed and disposed off site? Yes No
Disposal Site: _____
- All underground cavities** crushed and filled with soil or rock material? Yes No or:
Removed and disposed off site? Yes No
Disposal Site: Pit to be filled in with soil
- Future discharge to system permanently denied? Yes No
Method(s) used: outhouse to be removed from cement base & cement base/seat to be removed

*Contaminated materials = Distribution media, soil or sand within three feet of the system bottom, distribution pipes, geotextile fabric/rosin paper/straw, tanks, contaminated soil around leaking tanks, any soil that received sewage from a surface failure (7080.2500 subp. 3).

**Underground cavities = Cesspools, leaching pits, drywells, seepage pits, vault privies, pit privies, pump chambers (7080.2500 subp. 1). Does not include chamber media, drop boxes, or distribution boxes.

Map

Include location of building sewer, septic tank(s), soil dispersal system, cesspools, seepage pits, and other pits. Also include a permanent reference point(s) and dimensions.

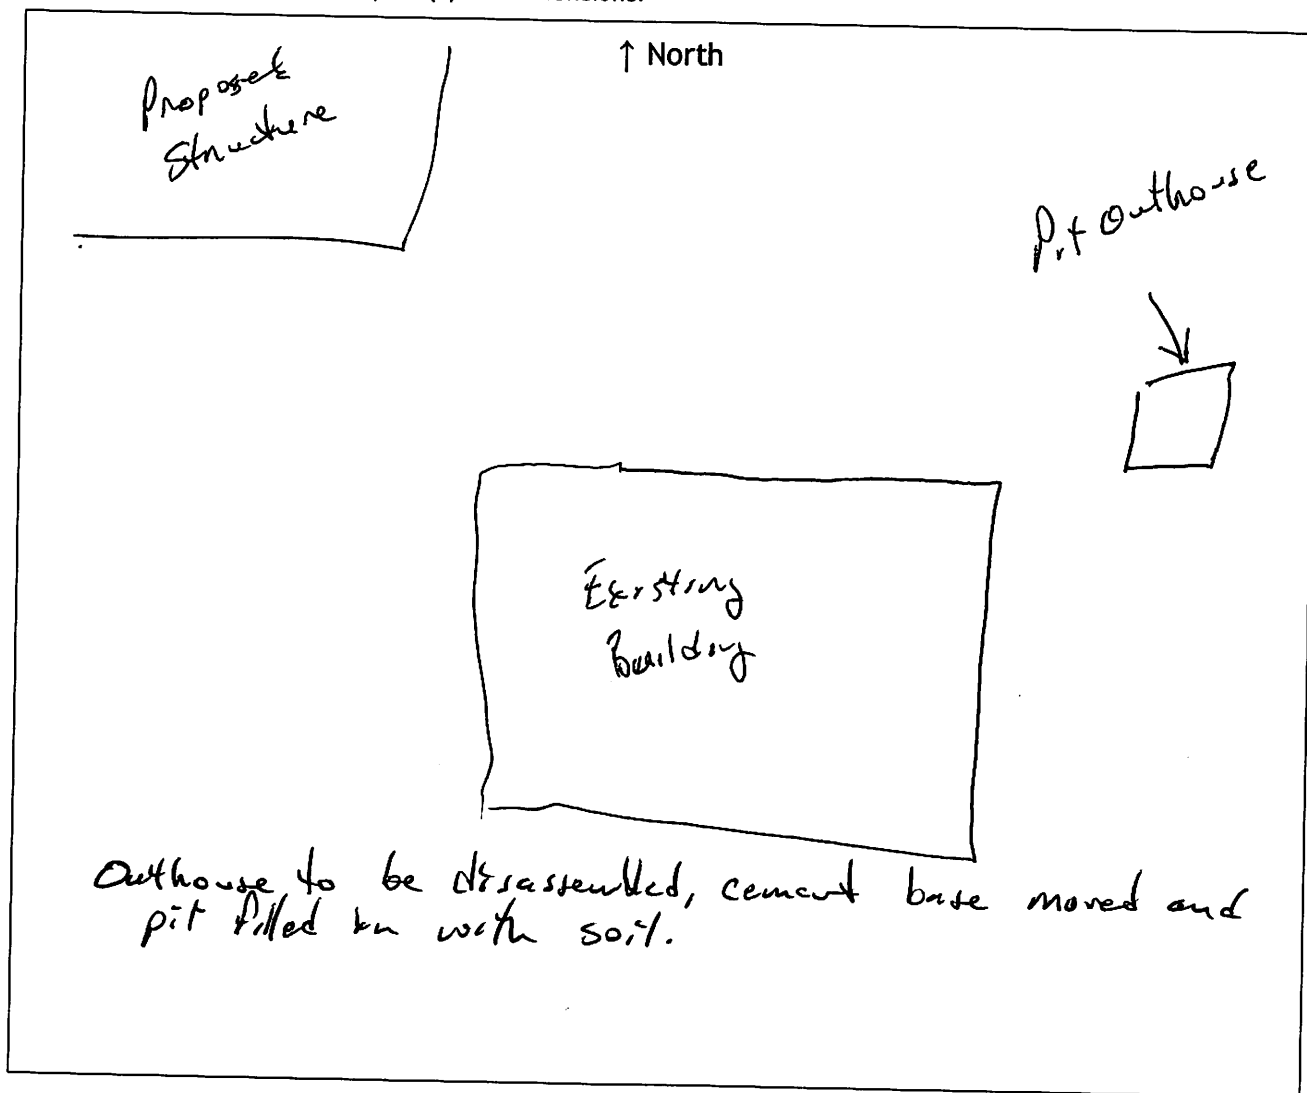

Certification

I hereby certify the system was abandoned in accordance with Minn. R. 7080.2500 and any local requirements.

Name (please print): Greg Hansen Title: Property Owner

Address: 5347 Evan Rd

City: Duluth State: MN Zip: 55804

Phone: 218-349-0342 License # if applicable: NA

Date: 7-8-2019 Signature: Greg Hansen