


NO Well
NO SEPTIC SYSTEM

2.280

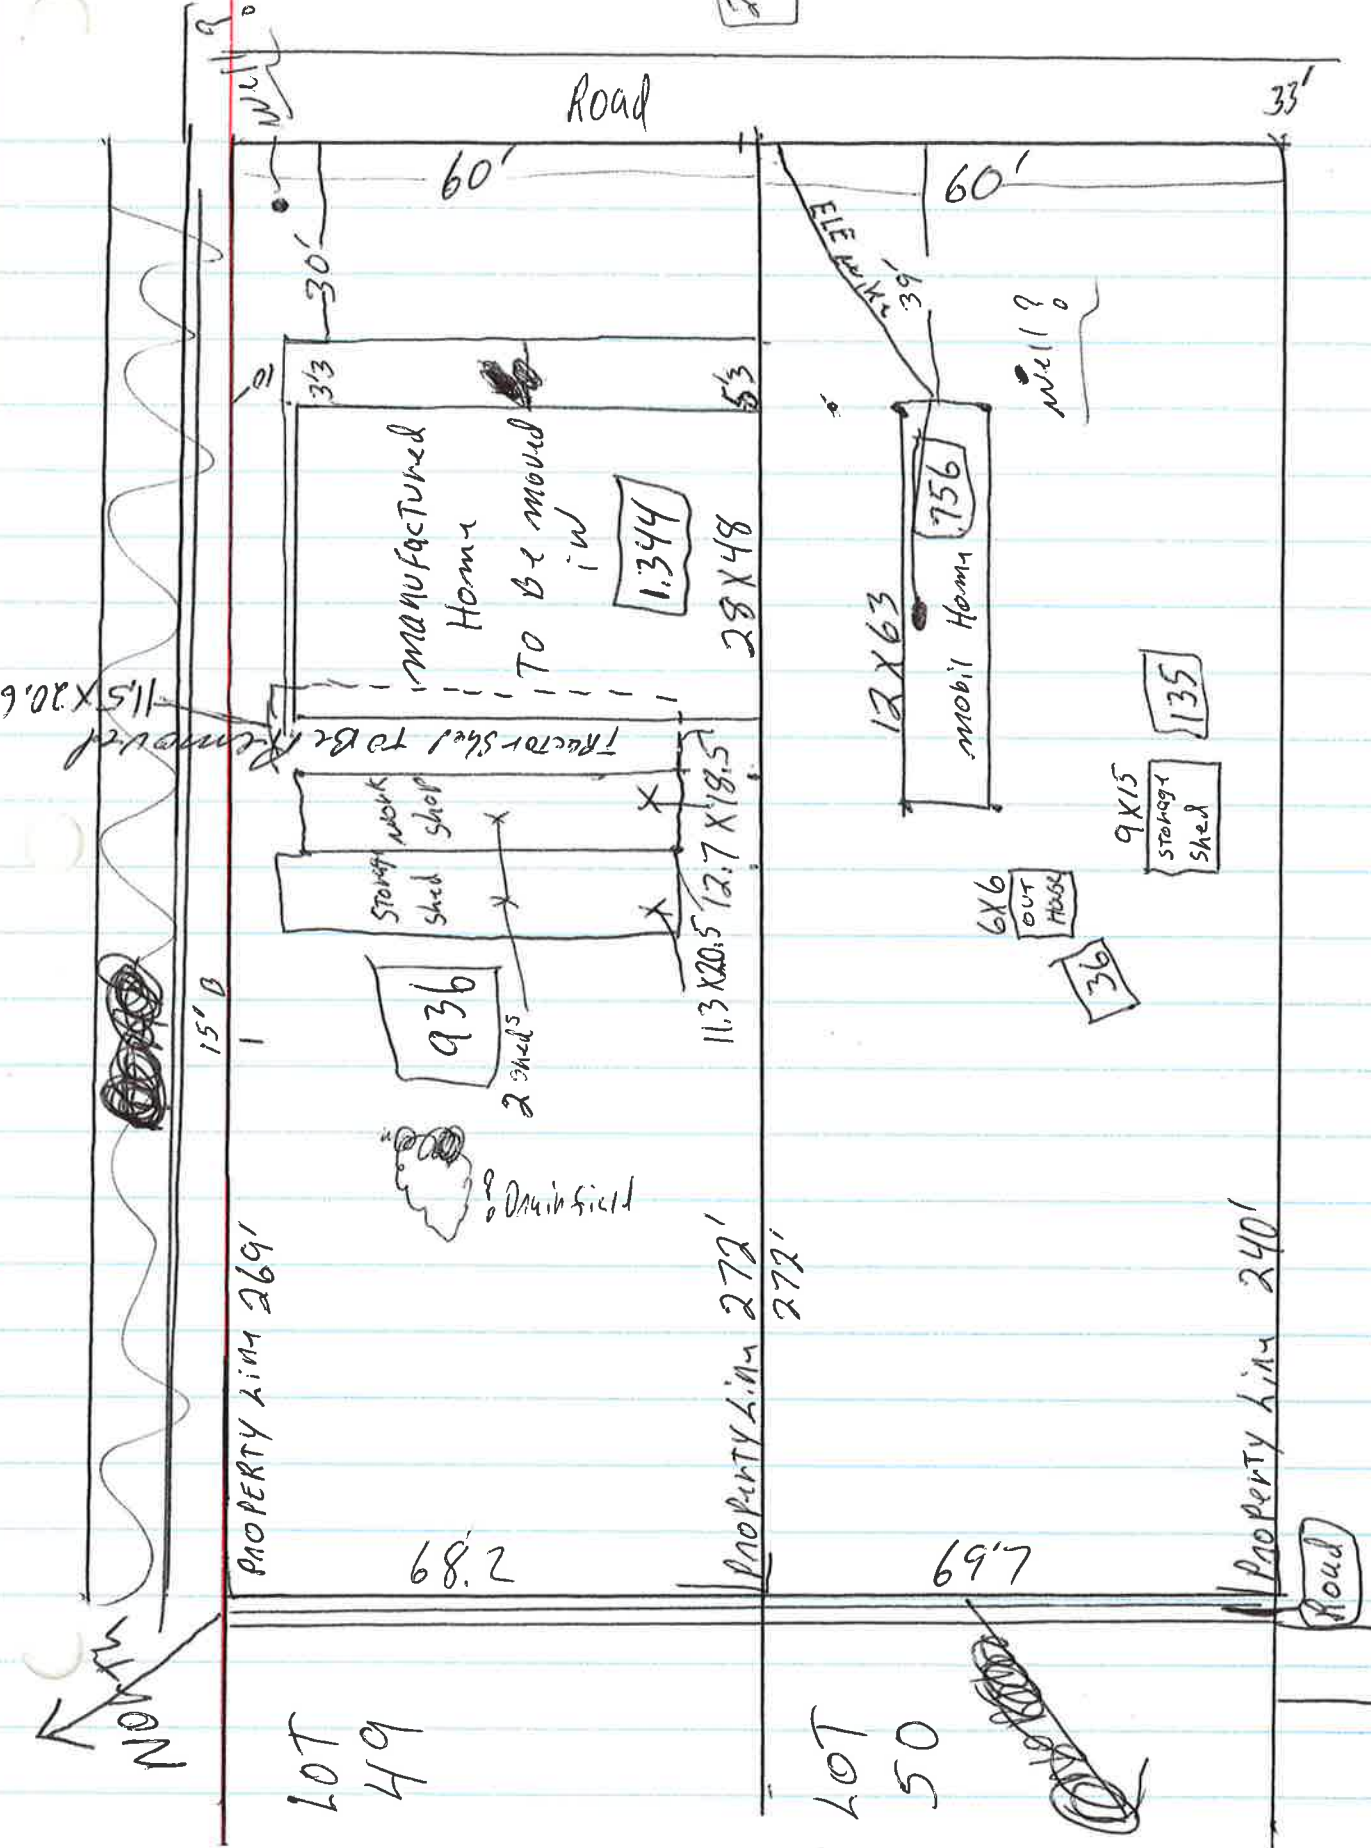

LOT 49

LOT 50

222 Feet next lots thru Big sandy lake (Bell Horn Bay)