

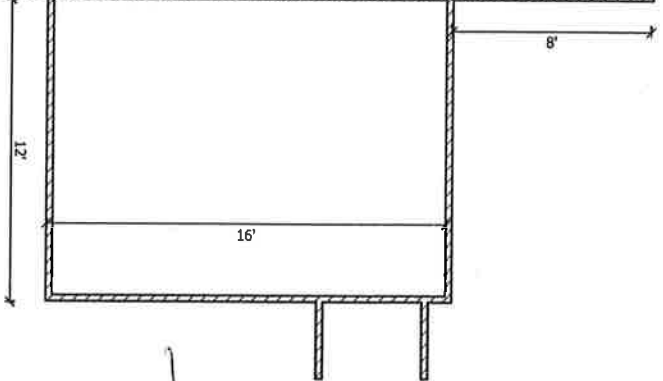


Not on Lake

Dave Herzelton
Septic 60ft

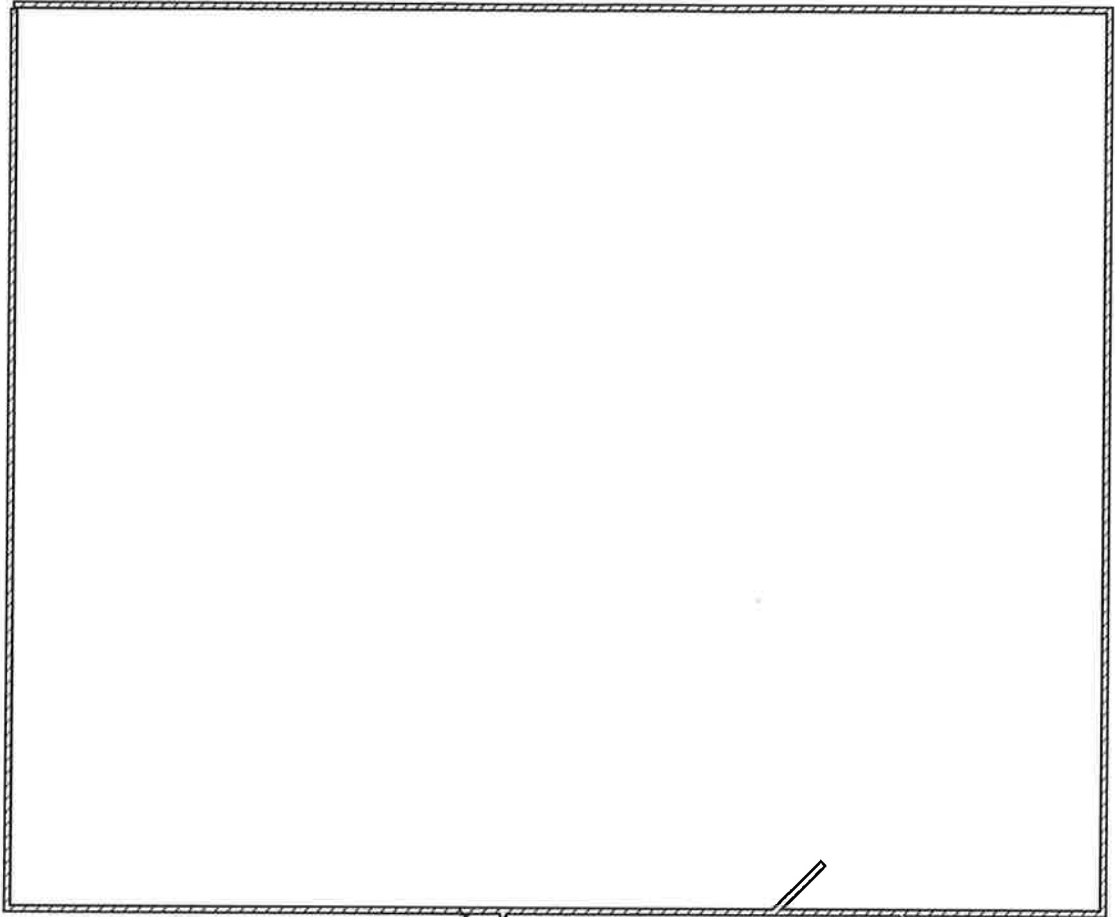

36x44 House

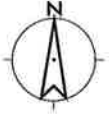

270-300 ft

305th Lane