


PLAN A

Residence

Residence

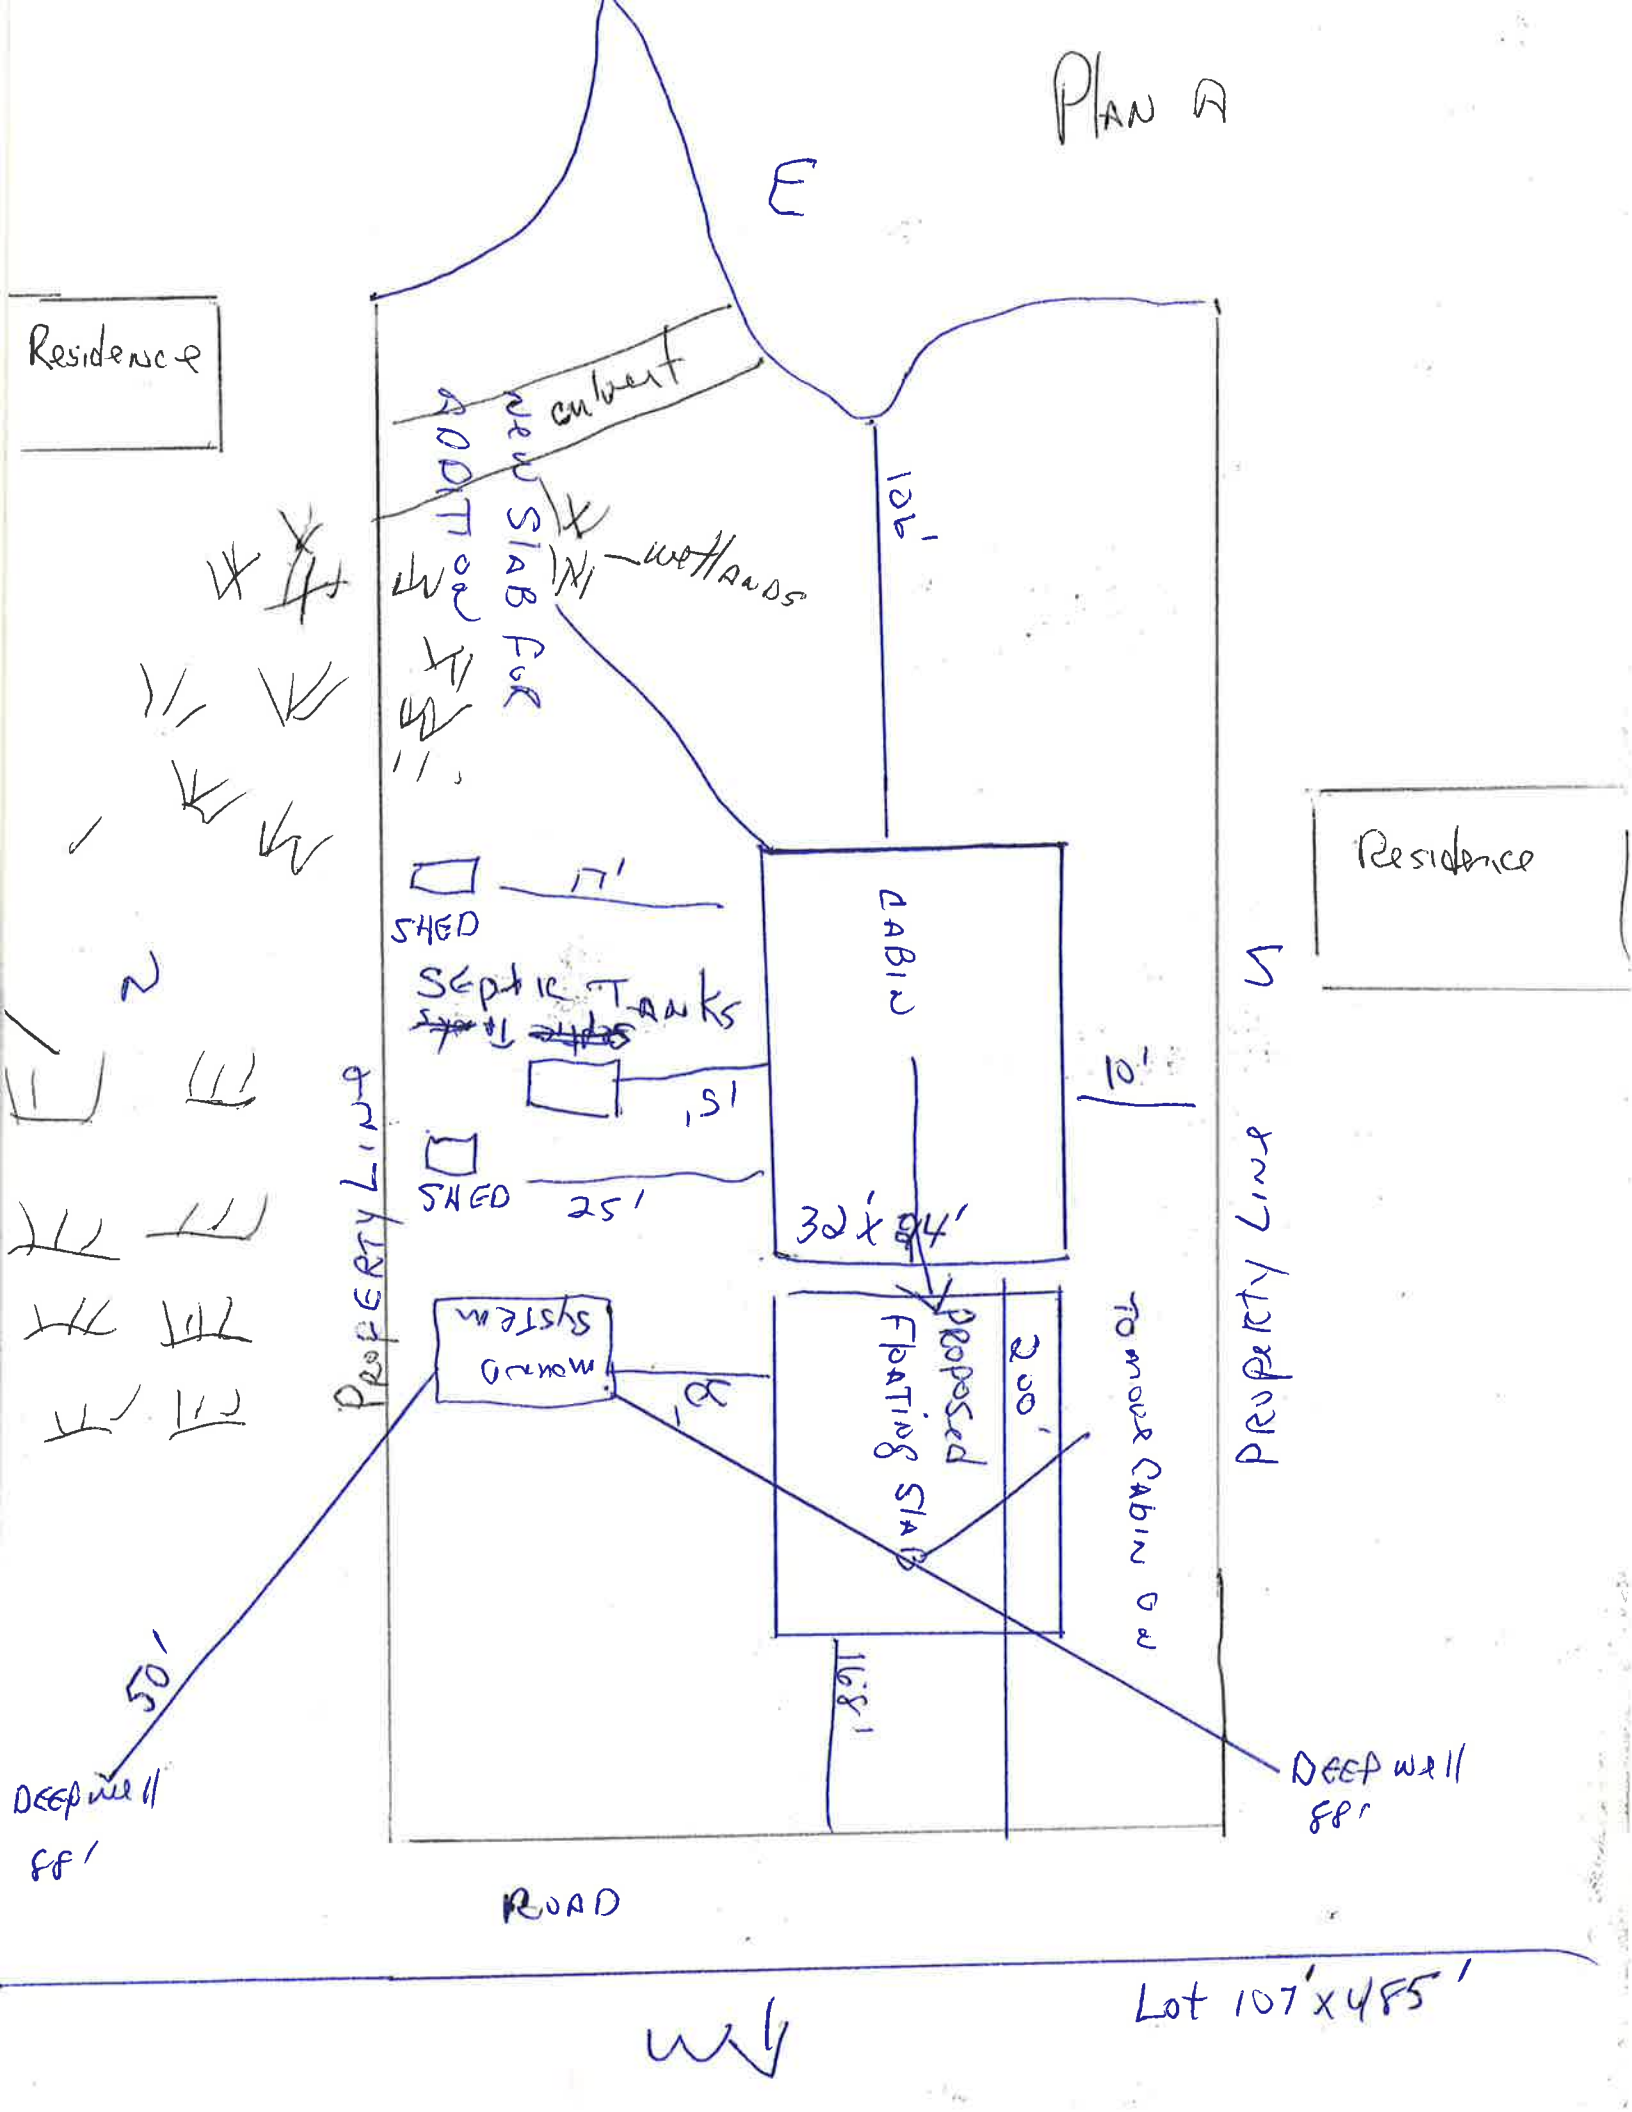

ROAD

Lot 107' x 485'

W

Plan B


sidewalk

culvert

Wetlands

106'

Residence

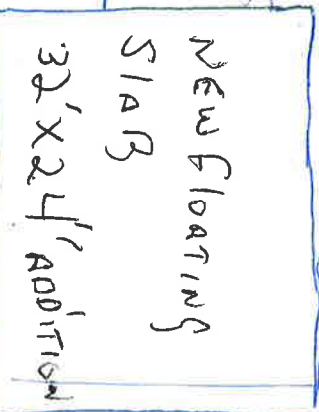

40'




Septic Tanks
15'

101'



MOUND SYSTEM 20'

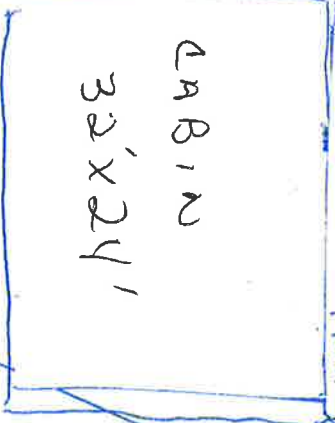

MOVE CABIN to FLOORING SLAB

PROPERTY LINE

PROPERTY LINE

50'

168'

DEEP Well
88'

ROAD

↓ WEST

LOT
107' x 485'



Wetlands

50'
sp well