AITKIN COUNTY	
CERTIFICATE OF INSTALLATION/NOTICE OF NONCOMPLIANCE	

This certificate of installation/notice of noncompliance has been issued this
day of, 20 to certify compliance\ noncompliance with Aitkin County's Subsurface Sewage Treatment System Ordinance.
Aitkin County's Subsurface Sewage Treatment System Ordinance.
The premises covered by this certificate are legally described as:
Section Township Range Lake PERMIT NO Owner Name
PERMIT NO. Owner Name
Address
Installer Name
Installer Name Type of System Inspected
Parcel Number
The certificate of installation/ notice of noncompliance was based on No of the following:
1) Inspection of the installation or construction as in accordance with the above
referenced permit and application design.
referenced permit and application design.
2) Review of as built plans submitted in accordance with Subdivision 0.2 D of
2) Review of as-built plans submitted in accordance with Subdivision 9.2 D of
Aitkin County's Subsurface Sewage Treatment System Ordinance.
If the choice normitted subsurface courses treatment eveters is in non-coursilence with
If the above permitted subsurface sewage treatment system is in noncompliance with
Aitkin County's Subsurface Sewage Treatment System Ordinance, then the following
shall serve as a Notice of Violation:
1) Statement of the findings of fact through inspections or investigations:
2) List of specific violations of Ordinance:
Requirements for correction or removal of violations:
4) Time schedule for compliance:
Failure to correct or remove the above violation(s) will result in this matter being
turned over to the Aitkin County Attorney's Office for further legal action, which may
result in revocation of licenses or registrations, fines and/or imprisonment.
INSPECTOR SIGNATURE


SUBSURFACE SEWAGE TREATMENT SYSTEM INSPECTION FORM
AITKIN COUNTY, MINNESOTA

Township Williams Date of Inspect	ion <u>8/72/2019 11/14/2019</u> App. Number <u>44352</u>
	Parcel Number <u>38-0-0/5360</u>
	Installer Dave Englahl
City <u>Finlayson</u> Zip Code <u>5</u>	5735 TI HBR Mound
	5/35 19DR Mound
New Repair	DIST. or DROP BOX & TYPE
SETBACKS:	TRENCHES, BEDS, OR GRAVELLESS LEACHFIELD:
Buildings to tank(s)	Trench/Bed depth
Buildings to drainfield <u>60'</u>	Trench/Bed length
Well(s) 50' or 100' DW! 100' to tank	Trench/Bed bottom w <u>idth</u>
Lake/Creek/Wetland	Trench spacing
	Drainfield rock below pipe
SEPTIC TANKS: New Kerner	Size of gravelless pipe
Number of tanks installed	Depth of backfill
Liquid capacity and type 1650 Jacobsen com	Absorption area: square feet/
Type of baffle <u>tasfic</u>	
	lineal feet
Inspection pipes	MOUNDS:
Inspection pipes Manholes size24" 20"	MOUNDS: Percent slope 7/2
Inspection pipes	MOUNDS: Percent slope 27_{0} Upslope sand width $7'$
Inspection pipes Manholes size24" 20 " Manhole to grade Yes V No	MOUNDS: Percent slope 7/2
Inspection pipes	MOUNDS: Percent slope 2.7_{0} Upslope sand width $7'$ Downslope sand width $16'$ Sideslope sand width $7'$
Inspection pipes Manholes size24" 20" Manhole to grade Yes_V No PUMPS: NewExisting Tank capacity and type <u>760 Tace been</u>	MOUNDS: Percent slope 2% Upslope sand width $7'$ Downslope sand width $16'$ Sideslope sand width $7'$ Drainfield rock below pipe $9''$
Inspection pipes Manholes size 24" 20" Manhole to grade Yes V No PUMPS: New Tank capacity and type 760 Tace been Pump manufacturer & model # Liberty 283	MOUNDS: Percent slope 2% Upslope sand width $7'$ Downslope sand width $16'$ Sideslope sand width $7'$ Drainfield rock below pipe $9''$ Depth of sand below rock $24''$
Inspection pipes Manholes size24" $20"$ Manhole to grade Yes V No PUMPS: New Existing Tank capacity and type $\underline{160 \ Tace bsen}$ Pump manufacturer & model # <u>Liberty 283</u> Horsepower & GPM <u>12HP</u> <u>38GPM</u>	MOUNDS: Percent slope 2^{\prime} Upslope sand width 7^{\prime} Downslope sand width 16^{\prime} Sideslope sand width 7^{\prime} Drainfield rock below pipe $9^{\prime\prime}$ Depth of sand below rock $24^{\prime\prime}$ Perforation size & spacing $0, 25^{\prime\prime}/36^{\prime\prime}$ Sp
Inspection pipesManholes size $24" 20"$ Manhole to gradeYesYesNoPUMPS:NewTank capacity and type 760 Tace beenPump manufacturer & model # $hiber tru 283$ Horsepower & GPM $1/2HP$ Feet of head $/3, 5'$	MOUNDS: Percent slope $2.\%$ Upslope sand width $7'$ Downslope sand width $16'$ Sideslope sand width $7'$ Drainfield rock below pipe $9''$ Depth of sand below rock $24''$ Perforation size & spacing $0.25''/36''$ sp Pipe size & spacing $1.5''/3.5'$ sp.
Inspection pipes Manholes size24" 20" Manhole to grade Yes V No PUMPS: New Existing Tank capacity and type <u>160 Tace beson</u> Pump manufacturer & model # <u>Liberty 283</u> Horsepower & GPM <u>12HP</u> <u>38GPM</u> Feet of head <u>13,51</u> Gallons per cycle	MOUNDS: Percent slope 2% Upslope sand width $7'$ Downslope sand width $16'$ Sideslope sand width $7'$ Drainfield rock below pipe $9''$ Depth of sand below rock $24''$ Perforation size & spacing $0.25''/36''$ Pipe size & spacing $1.5''/3.5'$ Dimensions of rock bed $10' \times 50'$
Inspection pipes Manholes size 24" $20"$ Manhole to grade Yes V No PUMPS: New Existing Tank capacity and type $\underline{760 \text{ Tace besn}}$ Pump manufacturer & model # <u>Liberty 283</u> Horsepower & GPM <u>1/2HP</u> <u>38GPM</u> Feet of head <u>13.51</u> Gallons per cycle Size of discharge line <u>1.51</u>	MOUNDS: Percent slope 2% Upslope sand width $7'$ Downslope sand width $16'$ Sideslope sand width $7'$ Drainfield rock below pipe $9''$ Depth of sand below rock $24''$ Perforation size & spacing $0.25''/36''$ Pipe size & spacing $1.5''/3.5'$ Dimensions of rock bed $10' \times 50'$
Inspection pipes Manholes size 24" $20"$ Manhole to grade Yes V No PUMPS: New Existing Tank capacity and type 760 Tace been Pump manufacturer & model # <u>Liberty 283</u> Horsepower & GPM <u>12HP</u> 38GPM Feet of head <u>13,51</u> Gallons per cycle Size of discharge line <u>1,5"</u> Type & location of alarm <u>Elcc. on tank</u>	MOUNDS: Percent slope $2.\%$ Upslope sand width $7'$ Downslope sand width $16'$ Sideslope sand width $7'$ Drainfield rock below pipe $9''$ Depth of sand below rock $24''$ Perforation size & spacing $0.25''/36''$ sp Pipe size & spacing $1.5''/3.5'$ sp.
Inspection pipes Manholes size24" 20" Manhole to grade Yes V No PUMPS: New Existing Tank capacity and type 760 Tacebean Pump manufacturer & model # <u>Liberty 283</u> Horsepower & GPM <u>1/2HP</u> 38GPM Feet of head3.5' Gallons per cycle Size of discharge line Type & location of alarm <u>E/cc. on tank</u> Water meter	MOUNDS: Percent slope 2% Upslope sand width $7'$ Downslope sand width $16'$ Sideslope sand width $7'$ Drainfield rock below pipe $9''$ Depth of sand below rock $24''$ Perforation size & spacing $0.25''/36''$ Pipe size & spacing $1.5''/3.5'$ Dimensions of rock bed $10' \times 50'$
Inspection pipes Manholes size 24" $20"$ Manhole to grade Yes V No PUMPS: New Existing Tank capacity and type 760 Tace been Pump manufacturer & model # <u>Liberty 283</u> Horsepower & GPM <u>12HP</u> 38GPM Feet of head <u>13,51</u> Gallons per cycle Size of discharge line <u>1,5"</u> Type & location of alarm <u>Elcc. on tank</u>	MOUNDS: Percent slope 2% Upslope sand width $7'$ Downslope sand width $16'$ Sideslope sand width $7'$ Drainfield rock below pipe $9''$ Depth of sand below rock $24''$ Perforation size & spacing $0.25''/36''$ Pipe size & spacing $1.5''/3.5'$ Dimensions of rock bed $10' \times 50'$

Inspector's Comments: ___

Inspector's Signature _____

Site Drawing

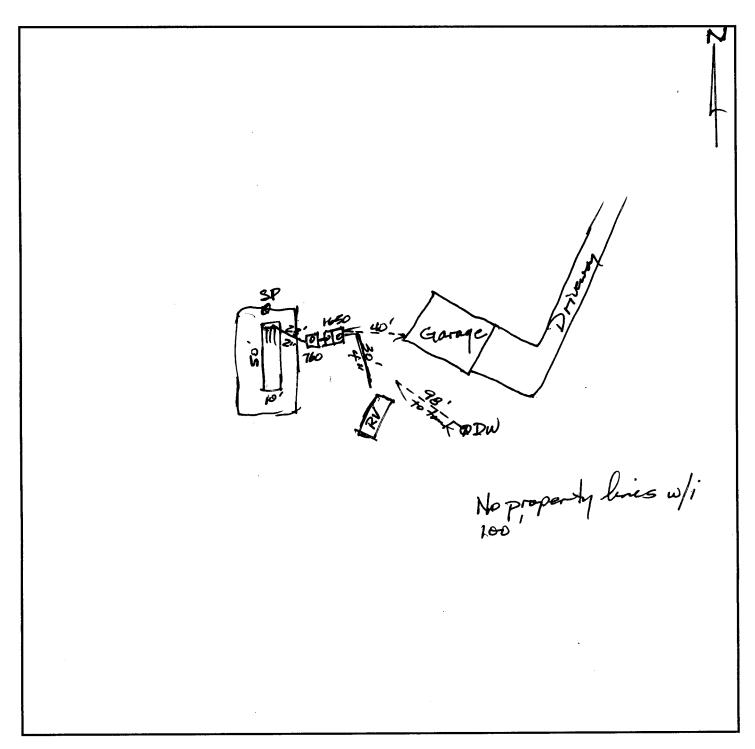

Soils			
A	0-5"	104R3/2 7.54R5/3	FSL
B	8-12 12-19"	7.54R4/4	FSL
ZB	19"+	54R 4/4 Redox @ 19"	SL
		7.5YK5/6	

Notes				
	 	<u> </u>	 	

Davis Dirt 6-26-19

JACOBSON PRECAST CONCRETE, LLC

TANK INSTALLATION INSTRUCTIONS

Model # 165055 Date Built: 5' 17.19 Gallons: 1650 Bury Depth 3' HE W Model # 760P Date Built: 10.4.17 Gallons: 760 Bury Depth 3'

SITE CONDITION:

The site must be accessible to large, heavy trucks. Free of items like trees, stumps, overhead wires, etc. That could interfere with delivery or installation and allows trucks to within 3 to 5 ft of placement excavation.

EXCAVATION:

Excavation should be approximately 12" minimum larger than tank size to allow for adequate back fill. This may vary with soil conditions. Excavation shall have a level bottom so the weight bears on the outside walls of the tank.

BEDDING:

Each tank should be placed on about 6" of proper bedding material leveled, and should be compacted to minimum 95% compaction if tested, to ensure the life of the tank structure. Bedding must be capable of bearing the weight of the tank. Bedding material shall have the ability of 100% to pass through a %" screen.

WATER TABLE:

When tanks are being placed where water levels can potentially be higher than the elevation of the tank cover, an alternate location should be considered. If water table is high installer must also consider the tank my float, if this is a possibility tank must be tied down before backfilling.

BACKFILL MATERIAL:

Sidewall of tanks require dry backfill materials that have the ability of 100% to be able to pass through a 2" screen and a minimum of 12" on all sides from the bottom to top of tank. Backfill material shall be placed to avoid impact loads on sidewall of the tank.

COVER MATERIAL:

Cover material shall be dry soil, material that has the ability of 100% to be able to pass through a 2' screen. Cover material shall be mounded over tank and around risers to direct run-off away from both.

INLET & OUTLET:

Pipe not to exceed 1" past the interior wall of tank where a baffle is used.

BURIAL DEPTH: Tanks to be installed according to model's maximum bury recommendations: