


{ Design Drawing }

Property Owner: Curtis Weitnauer Date: 7/1/19 Designer's Initials: JB
 Parcel ID. Number: 11-0-061800 Address: East side of 435th Ave. North of Jct 236th Ln.
 one Inch = 40ft.

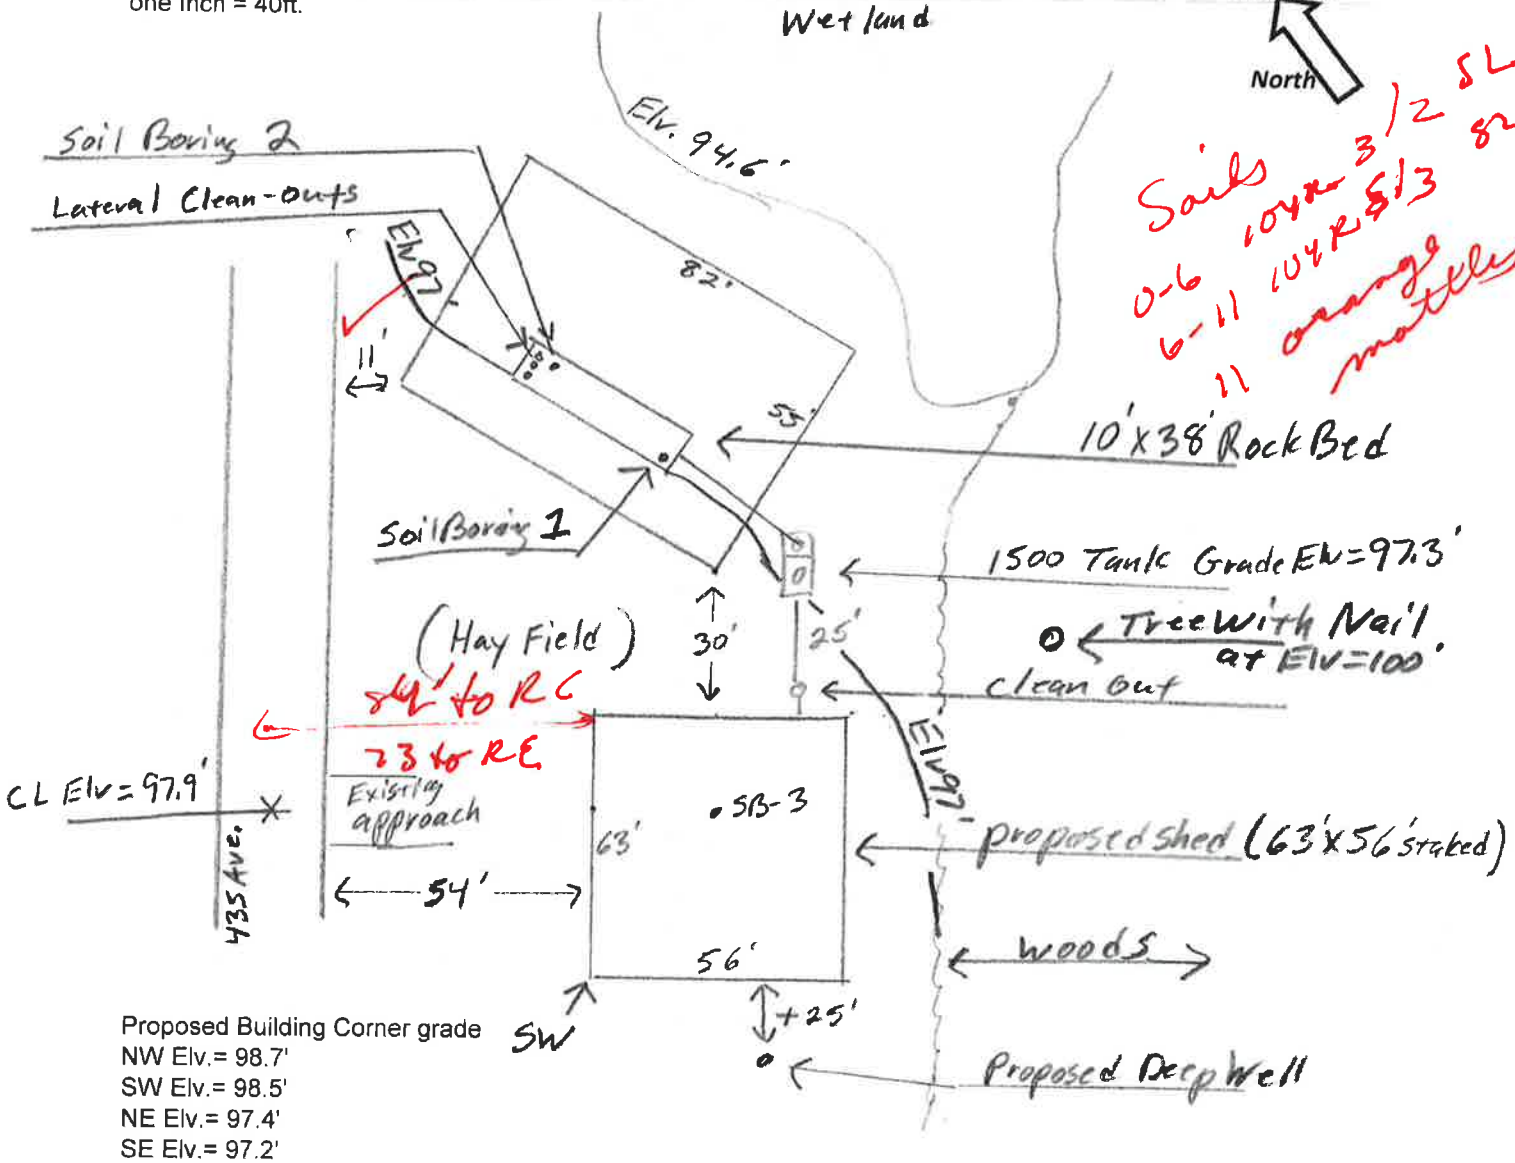

	Surface/ SHWT	Nail on Tree = Bench Mark 100'		Existing Grade	
Soil Bore 1	96.9'/11"	Bench Mark	100'	Upslope Edge of Rockbed	Elv.= 97'
Soil Bore 2	96.7'/10"	Ground Elv. BM	96.9'	Bottom of Rockbed	Elv.=100'
Soil Bore 3	98.2'/10"	Ground Elv. Tank	97.3'	Top of Wased Sand	Elv.=100'
Ground at Proposed house					

Please show all that apply (Existing)

Wells within 100ft. Of Drain field.

Water lines within 10 ft. of Drain field.

Drain field Areas: Mound 55' x 82'

Please Draw to Scale with North to Top or Left Side of Page:

Disturbed/Compacted Areas	Access Route for Tank Maintenance
Component Location	Property Lines
OHW ordinary high water	Structures
Lot Easements	Setbacks