

**SUBSURFACE SEWAGE TREATMENT SYSTEM INSPECTION FORM
AITKIN COUNTY, MINNESOTA**

Township Horse Fork Date of Inspection 7-15-19 App. Number 2019-004729

Owner Michael & Colette Peterson Parcel Number 11-8-037602

Project Address 42929 255th Ln Installer Self

City Aitkin Zip Code 56431

New Repair DIST. or DROP BOX & TYPE _____

SETBACKS:

Buildings to tank(s) _____
Buildings to drainfield _____
Wells(s) 50' or 100' _____
Lake/Creek/Wetland _____

TRENCHES, BEDS, OR GRAVELLESS LEACHFIELD:
Trench/Bed depth _____
Trench/Bed length _____
Trench/Bed bottom width _____
Trench spacing _____
Drainfield rock below pipe _____
Size of gravelless pipe _____
Depth of backfill _____
Absorption area: square feet _____
lineal feet _____

SEPTIC TANKS: New Existing _____


Number of tanks installed 1 Swedish
Liquid capacity and type 16575 plastic
Type of baffle Plastic
Inspection pipes —
Manholes size 15 20" 25 24"
Manhole to grade Yes No _____

MOUNDS:
Percent slope _____
Upslope sand width _____
Downslope sand width _____
Sideslope sand width _____
Drainfield rock below pipe _____
Depth of sand below rock _____
Perforation size & spacing _____
Pipe size & spacing _____
Dimensions of rock bed _____
Dimensions of sand base _____
Final cover _____

PUMPS: New _____ Existing _____

Tank capacity and type _____
Pump manufacturer & model # _____
Horsepower & GPM _____
Feet of head _____
Gallons per cycle _____
Size of discharge line _____
Type & location of alarm _____
Water meter _____

DRAWING OF SYSTEM: (include soils)
255 Ln

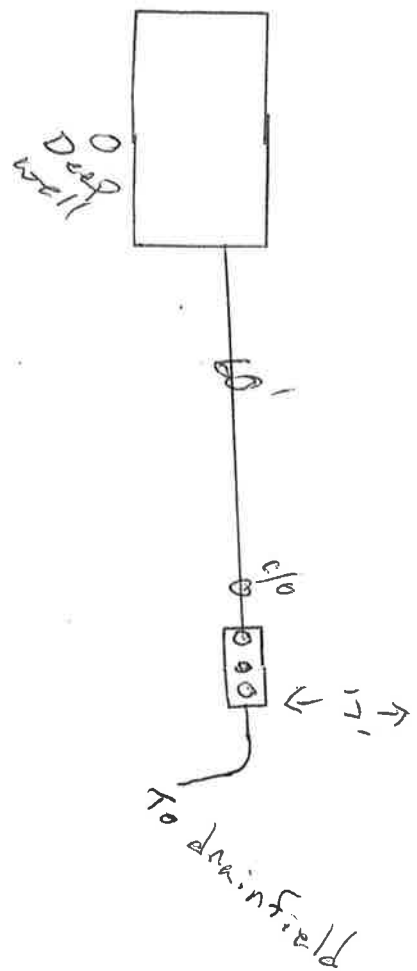

Inspector's Comments: _____

Inspector's Signature [Signature] Installer's Signature _____

Rev: 1/13 White - County Yellow - Applicant Pink - Installer

AITKIN COUNTY
CERTIFICATE OF INSTALLATION/NOTICE OF NONCOMPLIANCE

This certificate of installation/~~notice of noncompliance~~ has been issued this 17TH day of July, 20 19 to certify compliance/~~noncompliance~~ with Aitkin County's Subsurface Sewage Treatment System Ordinance.

The premises covered by this certificate are legally described as: 350 ft X 375 ft of NW SW

Section 15 Township 45 Range 27 Lake _____
PERMIT NO. 44401/2019-084729 Owner Name Michael & Gretchen Patnode
Address 42929 255th Ln
Installer Name Self
Type of System Inspected Tank Replacement
Parcel Number 11-0-037642

The certificate of installation/~~notice of noncompliance~~ was based on No 1 of the following:

- 1) Inspection of the installation or construction as in accordance with the above referenced permit and application design.

- 2) Review of as-built plans submitted in accordance with Subdivision 9.2 D of Aitkin County's Subsurface Sewage Treatment System Ordinance.

If the above permitted subsurface sewage treatment system is in noncompliance with Aitkin County's Subsurface Sewage Treatment System Ordinance, then the following shall serve as a Notice of Violation:

- 1) Statement of the findings of fact through inspections or investigations:

- 2) List of specific violations of Ordinance: _____

- 3) Requirements for correction or removal of violations: _____

- 4) Time schedule for compliance: _____

Failure to correct or remove the above violation(s) will result in this matter being turned over to the Aitkin County Attorney's Office for further legal action, which may result in revocation of licenses or registrations, fines and/or imprisonment.

INSPECTOR SIGNATURE 





