
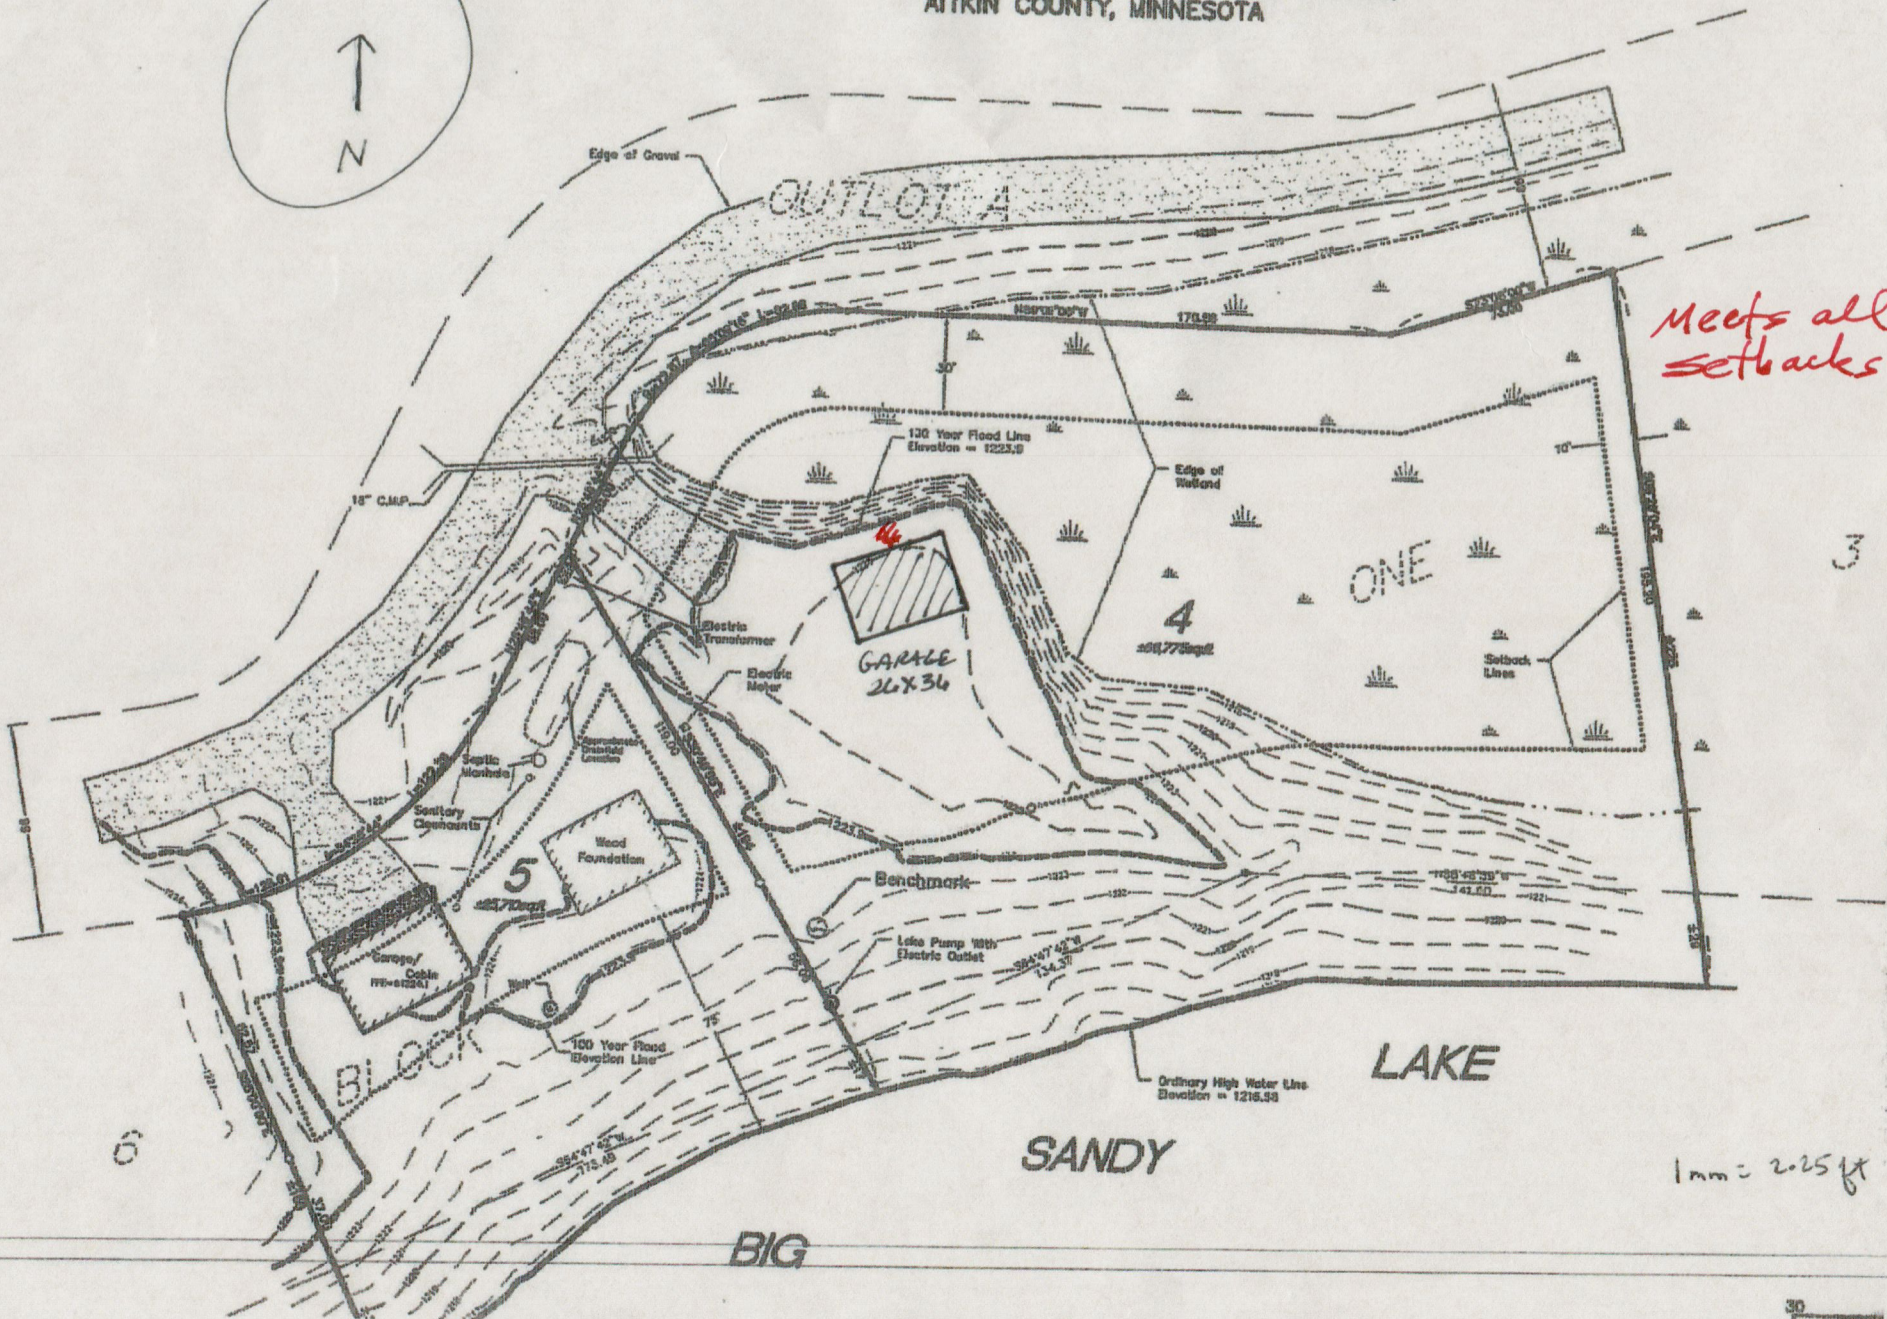



# CERTIFICATE OF SURVEY

LOT 4, AND LOT 5, BLOCK ONE, INDIAN SHORES,  
AITKIN COUNTY, MINNESOTA

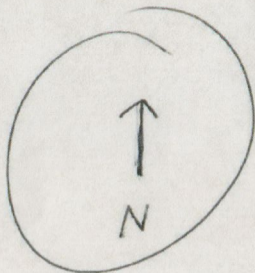

*Meets all setbacks*

1 in = 20.25 ft

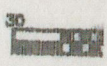





2019/07/30





2019/07/30





2019/07/30