



THOR 78

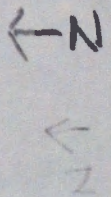

NOT LINED

156' W.P.L.

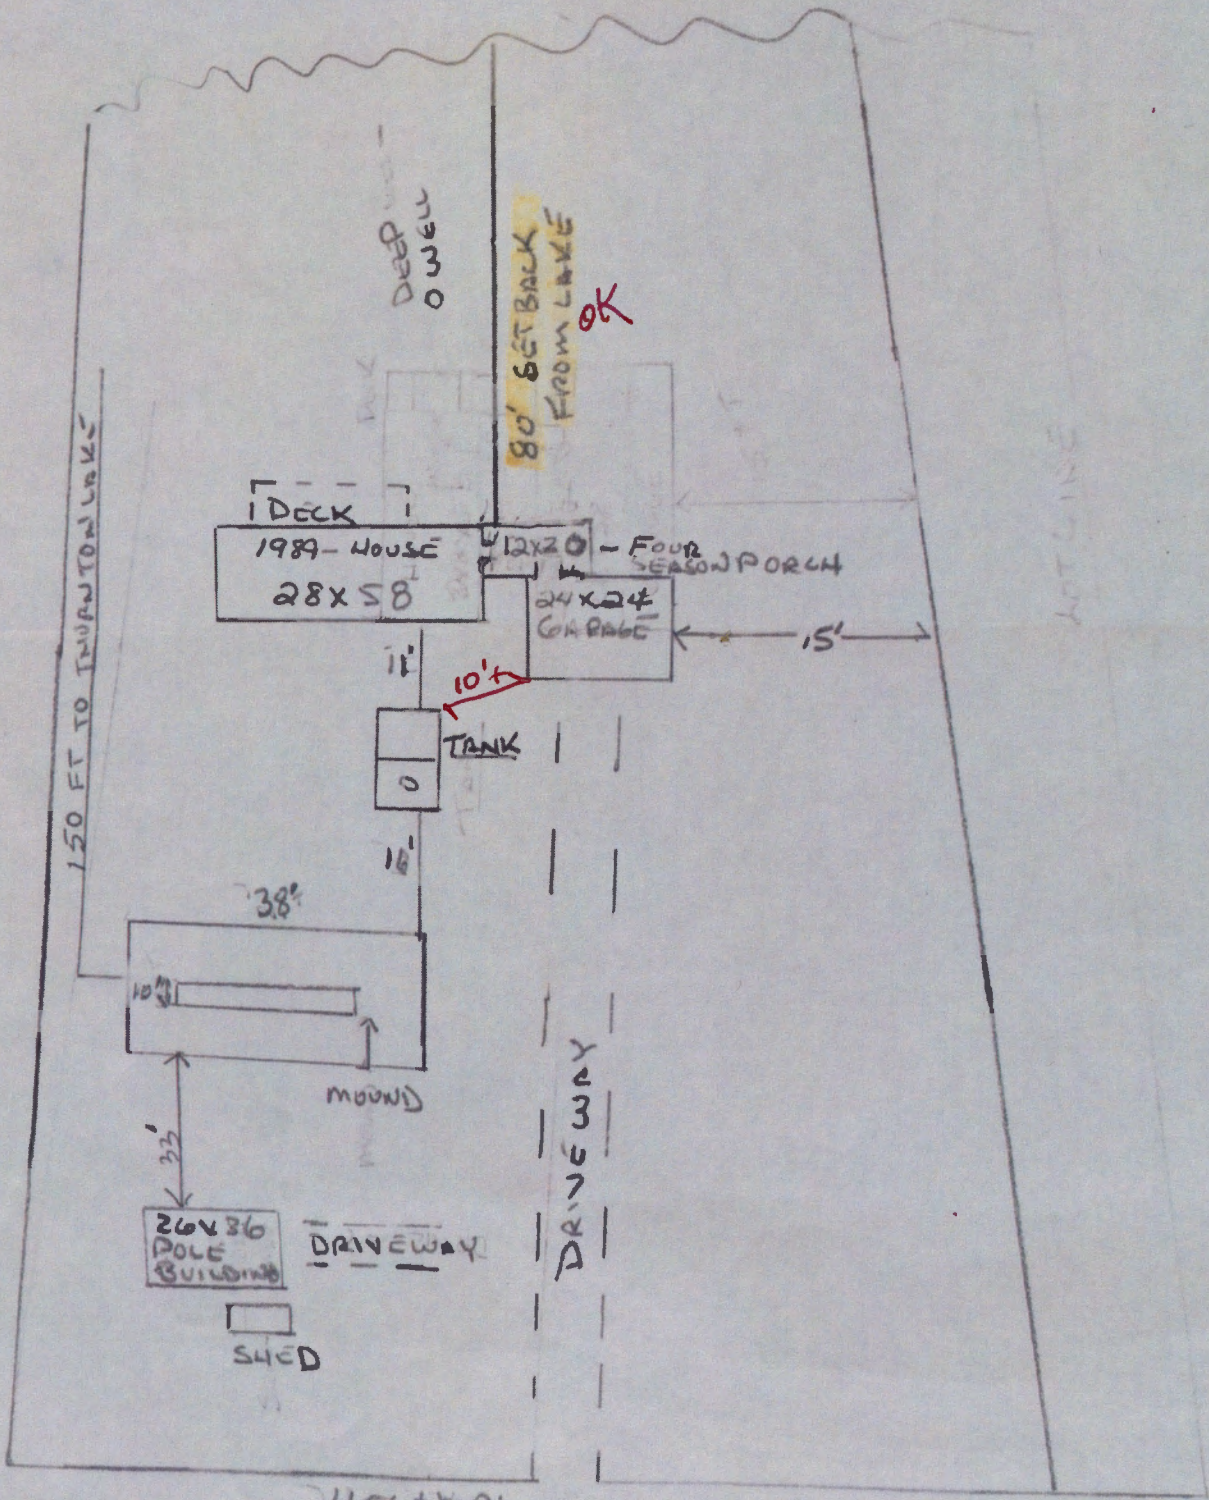



2019/07/09





2019/07/09





2019/07/09