

FIELD EVALUATION SHEET

PRELIMINARY EVALUATION DATE 6/1/19, FIELD EVALUATION DATE 7/1/19
PROPERTY OWNER: Robert Carlson PHONE _____
ADDRESS: 63881 199th Pl CITY, STATE, ZIP: Facboson MN 55752
LEGAL DESCRIPTION: _____
PIN# 06-0-0064 09 SEC 4 T 51 R 23 TWP NAME _____
FIRE# _____ LAKE/RIVER Little Ball Bluff LAKE CLASS Nat. OHWL _____ FT.

DESCRIPTION OF SOIL TREATMENT AREAS

	AREA #1	AREA #2	REFERENCE BM ELEV. _____ FT.
DISTURBED AREAS	YES ___ NO ___	YES ___ NO ___	REFERENCE BM DESCRIPTION _____
COMPACTED AREAS	YES ___ NO ___	YES ___ NO ___	_____
FLOODING	YES ___ NO ___	YES ___ NO ___	_____
RUN ON POTENTIAL	YES ___ NO ___	YES ___ NO ___	_____
SLOPE %	<u>15%</u>	_____	_____
DIRECTION OF SLOPE	<u>E-W</u>	_____	_____
LANDSCAPE POSITION	_____	_____	_____
VEGETATION TYPES	_____	_____	_____

DEPTH TO STANDING WATER OR MOTTLED SOIL: BORING# 1 _____, 1A _____, 2 _____, 2A _____

BOTTOM ELEVATION--FIRST TRENCH OR BOTTOM OF ROCK BED: #1 _____ FT., #2 _____ FT.

SOIL SIZING FACTOR: SITE # 1 _____, SITE #2 _____

CONSTRUCTION RELATED ISSUES: Holding Tanks - No Room for Drains

LIC# 1174 SITE EVALUATOR SIGNATURE: Daly

SITE EVALUATOR NAME: _____ TELEPHONE# _____

LUG REVIEW _____ DATE _____

Comments: _____

SOIL BORING LOGS ON REVERSE SIDE




Robert + Mada Carlson

06-0-006409

63881 199th Pl

Jacobson, MN 55752

Two 1,500 gal Holding Tanks

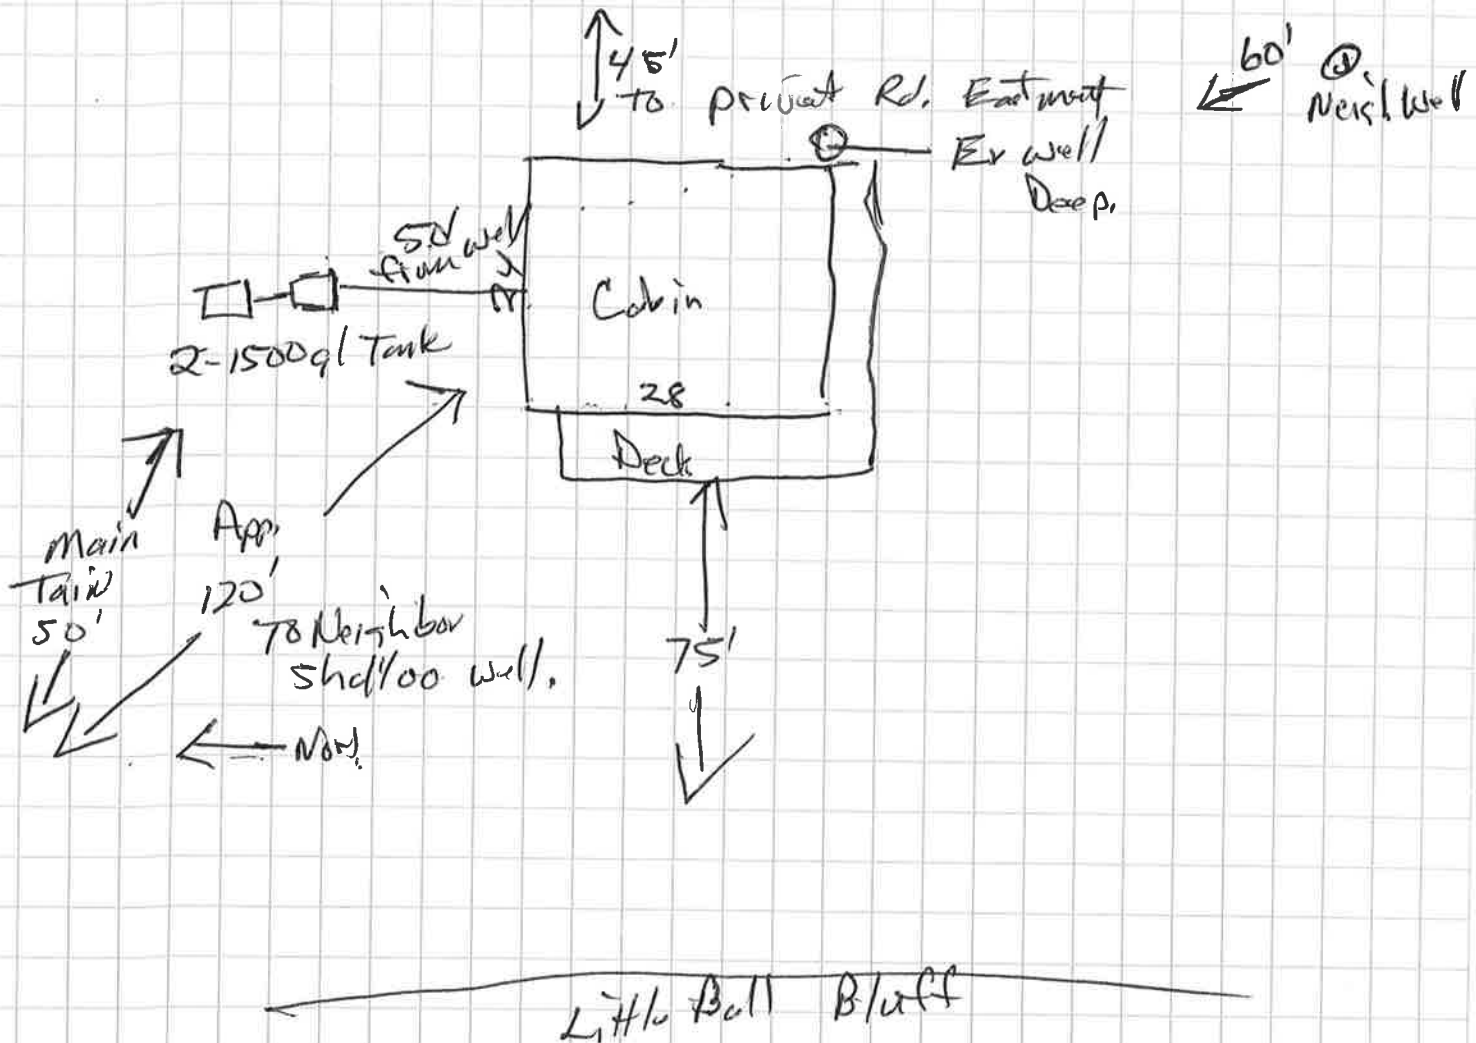

St Paul
651-647-0950

St Cloud
320-251-5060

Eagan
651-686-5036

Elk River
763-441-2004

Duluth
218-628-2231

Brainerd
218-829-1929

Rochester
507-282-2421

Mankato
507-388-1973

Decorah
701-222-3010

Fargo
701-282-9255

Minot
701-839-0509

Sioux Falls
605-339-1977

HOLDING TANK PUMPING SERVICE AGREEMENT

Permit # _____ Address 63881 199th place Jackson MN 55752

THIS AGREEMENT, entered into by and between Aitkin County Registered Septic Tank Pumper, _____, hereinafter referred to as "Contractor", and _____, hereinafter referred to as "Homeowner".

WHEREAS, Homeowner desires and is required to retain individual sewage treatment system holding tank services to protect the environment and to obtain a certificate of compliance from Aitkin County; and

WHEREAS, the Contractor desires to provide sewage treatment system pumping services to Homeowner as necessary and in accordance with the terms and conditions outlined herein.

NOW THEREFORE, in consideration of the mutual promises contained herein, Parties do hereby agree as follows:

1. **TERM.** The term of this Agreement shall be from 7/1/18 to final installation of an Aitkin County approved sewage treatment system or connection to a Municipal Sewage Treatment System, unless earlier terminated as provided herein. The parties understand and agree that this Agreement is intended to arrange for the provision of pumping services so that Homeowner may occupy the home pursuant to a certificate of compliance to be issued by the Aitkin County Environmental Services Department upon execution of this Agreement. Homeowner further agrees that at the earliest possible date, Homeowner shall have a permanent sewage treatment system installed in accordance with the Aitkin County Subsurface Sewage Treatment System Ordinance and as approved by the Aitkin County Environmental Services Department or connect to a Municipal Sewage Treatment System. Upon approval by the County of Aitkin of the individual sewage treatment system or connection to a municipal sewer, or approval by Aitkin County Environmental Services of an amended or different contract, this Agreement shall terminate.

2. **FREQUENCY OF PUMPING.** Homeowner agrees that he/she shall not allow the holding tank to overflow or discharge in any manner. Contractor and Homeowner agree that the holding tank shall be pumped in accordance with the following:

- Tank size (gal.) _____ / (number of household occupants multiplied by 75 gallons per day) = frequency of pumping; or
- Within 24 hours of indication by tank alarm of lack of capacity (applicable only if system has a functional alarm):
- Whichever is greater

Contractor agrees to provide pumping services according to the regular pumping schedule or as needed to prevent discharge. Homeowner shall compensate Contractor as agreed by the parties for pumping services rendered.

3. **INSPECTION.** Holding tanks will be inspected by a licensed pumper at the time of servicing for leaks below the operating depth and whether tank tops, riser joints, and connections leak through visual evidence of major defects.

4. **REPORTING.** Grievances of Homeowner or Contractor shall be reported to the Aitkin County Environmental Services Department by Homeowner or Contractor. Homeowner and Contractor understand that failure to have holding tank pumped as herein specified or the discharge of any contents from the holding tank, regardless of fault, may result in the suspension, cancellation or revocation of the certificate of compliance, and the homeowner may be required to vacate the premises.

Contractor LANGE / Buwes Pumping
20693 Blue Bird Drive
Grand Rapids
Date 7/9/19

Homeowner _____
Date _____

218-326-2967