



1" = 30'

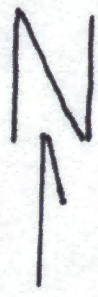

NORTH LOT LINE



85' eK

OK
100' +

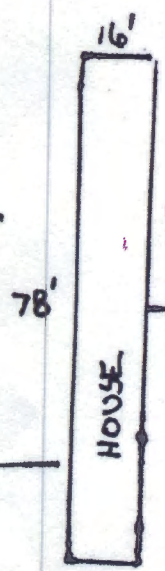


4" SCH 40
15'

1650 COMBO.

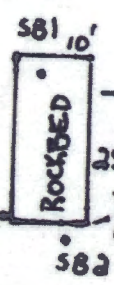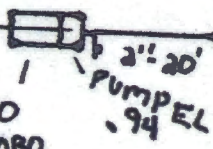

ROCK
EL 104

EAST LOT LINE

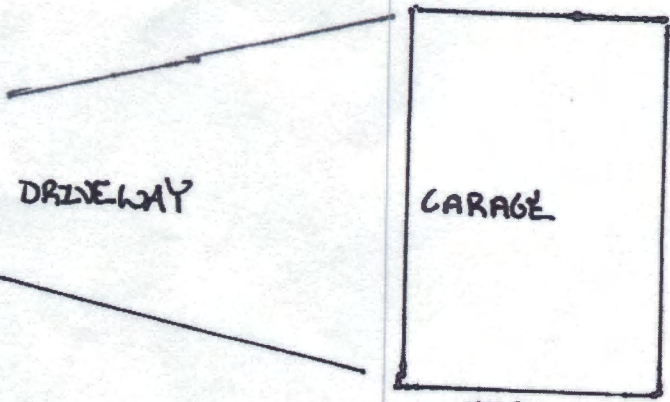

100 BM
GROUND LEVEL

100' +



2019/08/20



2019/08/20



2019/08/20