

AITKIN COUNTY
CERTIFICATE OF INSTALLATION/~~NOTICE OF NONCOMPLIANCE~~

This certificate of installation/~~notice of noncompliance~~ has been issued this _____ day of _____, 20____ to certify compliance/~~noncompliance~~ with Aitkin County's Subsurface Sewage Treatment System Ordinance.

The premises covered by this certificate are legally described as: _____

Section _____ Township _____ Range _____ Lake _____
PERMIT NO. _____ Owner Name _____
Address _____
Installer Name _____
Type of System Inspected _____
Parcel Number _____

The certificate of installation/~~notice of noncompliance~~ was based on No ___ of the following:

- 1) Inspection of the installation or construction as in accordance with the above referenced permit and application design.

- 2) Review of as-built plans submitted in accordance with Subdivision 9.2 D of Aitkin County's Subsurface Sewage Treatment System Ordinance.

If the above permitted subsurface sewage treatment system is in noncompliance with Aitkin County's Subsurface Sewage Treatment System Ordinance, then the following shall serve as a Notice of Violation:

- 1) Statement of the findings of fact through inspections or investigations:

- 2) List of specific violations of Ordinance: _____

- 3) Requirements for correction or removal of violations: _____

- 4) Time schedule for compliance: _____

Failure to correct or remove the above violation(s) will result in this matter being turned over to the Aitkin County Attorney's Office for further legal action, which may result in revocation of licenses or registrations, fines and/or imprisonment.

INSPECTOR SIGNATURE _____

**SUBSURFACE SEWAGE TREATMENT SYSTEM INSPECTION FORM
AITKIN COUNTY, MINNESOTA**

Township Nordland Date of Inspection 8/5/2020 App. Number 44699
 Owner Carol Ann Merron Parcel Number 24-0-044301
 Project Address 35805 310th St. Installer Larry Liljenquist
 City Aitkin Zip Code 56431 T1 3BR IG Trenches

New Repair

DIST. or DROP BOX & TYPE Drop boxes

SETBACKS:

Buildings to tank(s) No bldgs on site
 Buildings to drainfield "
 Well(s) 50' or 100' No well on parcel
 Lake/Creek/Wetland 200'+ to Mounson Lake

TRENCHES, BEDS, OR GRAVELLESS LEACHFIELD:

Trench/Bed depth 28"
 Trench/Bed length (3) 51' Trenches
 Trench/Bed bottom width 3'
 Trench spacing 6'
 Drainfield rock below pipe 9"
 Size of gravelless pipe —
 Depth of backfill 12"
 Absorption area: square feet 459 ft²
 lineal feet 153'

SEPTIC TANKS:

New Existing
 Number of tanks installed 1 Jackson
 Liquid capacity and type 1000
 Type of baffle Plastic
 Inspection pipes —

MOUNDS:


Percent slope —
 Upslope sand width —
 Downslope sand width —
 Sideslope sand width —
 Drainfield rock below pipe —
 Depth of sand below rock —
 Perforation size & spacing —
 Pipe size & spacing —
 Dimensions of rock bed —
 Dimensions of sand base —
 Final cover —

Manholes size 24"
 Manhole to grade Yes No

PUMPS:

New Existing
 Tank capacity and type —
 Pump manufacturer & model # —
 Horsepower & GPM —
 Feet of head —
 Gallons per cycle —
 Size of discharge line —
 Type & location of alarm Manual alarm
 Water meter —

DRAWING OF SYSTEM: (include soils)

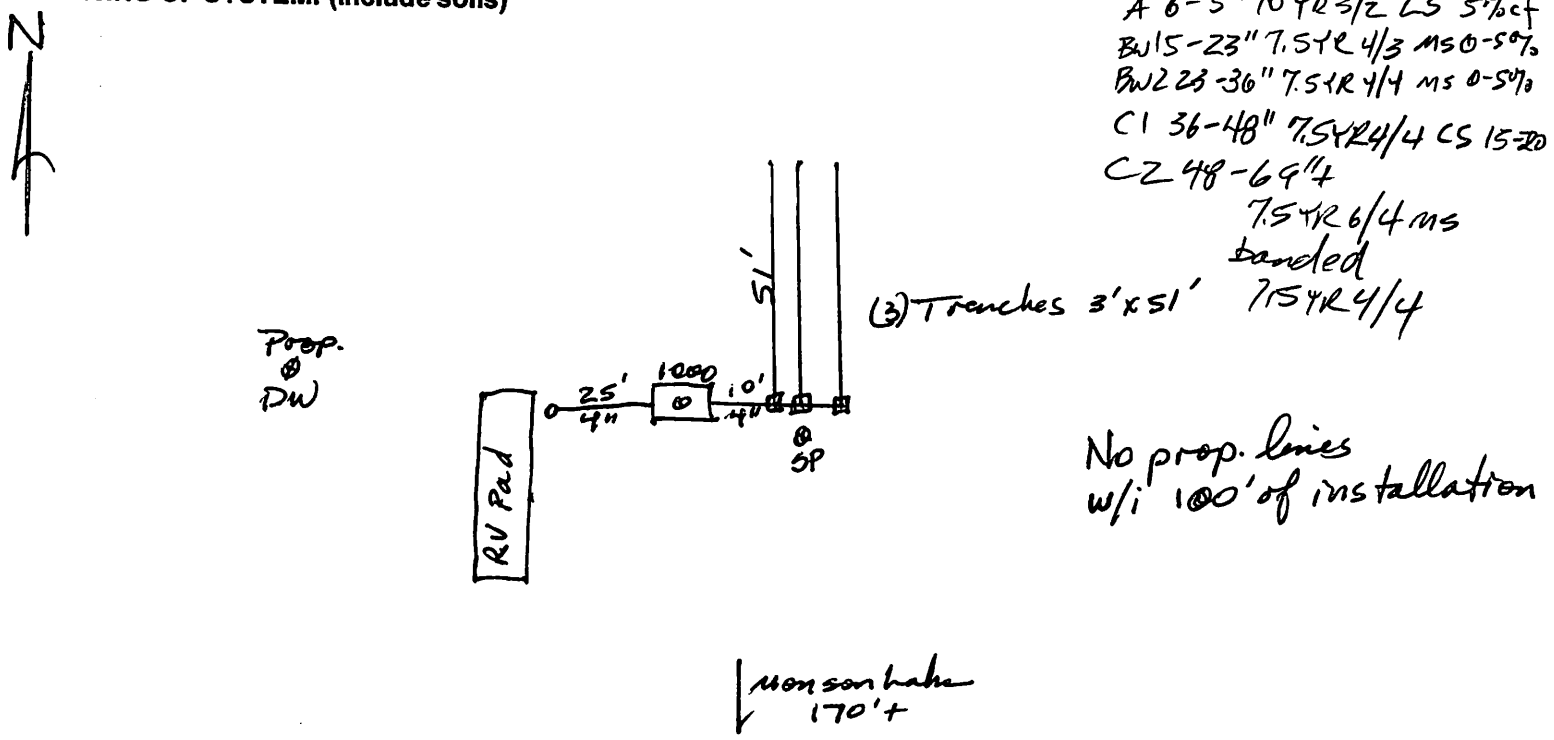

Inspector's Comments: 12" rock 28" depth

Inspector's Signature Bryan Hargrave Installer's Signature —



2020/08/05



2020/08/05



