

PRELIMINARY EVALUATION DATE

FIELD EVALUATION DATE

PROPERTY OWNER: **JAMES GAINES**

ADDRESS: **30956 326 LN**

CITY, STATE, ZIP: **ATKIN, MN 56431**

LEGAL DESCRIPTION:

PIN#

SEC      T      R      TWP NAME

FIRE#

LAKE/RIVER **LONG LAKE**

LAKE CLASS

OHWL

FT.

**DESCRIPTION OF SOIL TREATMENT AREAS**

	AREA #1	AREA #2
DISTURBED AREAS	YES <u>    </u> NO <u>    </u>	YES <u>    </u> NO <u>    </u>
COMPACTED AREAS	YES <u>    </u> NO <u>    </u>	YES <u>    </u> NO <u>    </u>
FLOODING	YES <u>    </u> NO <u>    </u>	YES <u>    </u> NO <u>    </u>
RUN ON POTENTIAL	YES <u>    </u> NO <u>    </u>	YES <u>    </u> NO <u>    </u>
SLOPE %	<u>    </u>	<u>    </u>
DIRECTION OF SLOPE	<u>    </u>	<u>    </u>
LANDSCAPE POSITION	<u>    </u>	<u>    </u>
VEGETATION TYPES	<u>    </u>	<u>    </u>

REFERENCE BM ELEV. 100 FT.  
 REFERENCE BM DESCRIPTION  
**GROUND LEVEL NEXT TO  
 EXISTING HOLDING  
 TANK**

DEPTH TO STANDING WATER OR MOTTLED SOIL: BORING# 1     , 1A     , 2     , 2A     

BOTTOM ELEVATION--FIRST TRENCH OR BOTTOM OF ROCK BED: #1      FT., #2      FT.

SOIL SIZING FACTOR: SITE #1     , SITE #2     

CONSTRUCTION RELATED ISSUES: **110 GALLON LIFT. USING 1500 EXISTING HOLDING TANK AND ADDING AN 1820 HOLDING TANK**

LIC# **127**

SITE EVALUATOR SIGNATURE: **Larry Liljenqvist**

SITE EVALUATOR NAME: **LARRY LILJENQVIST**


TELEPHONE# **218-820-8886**

LUG REVIEW     

DATE     

Comments:

# LONG LAKE

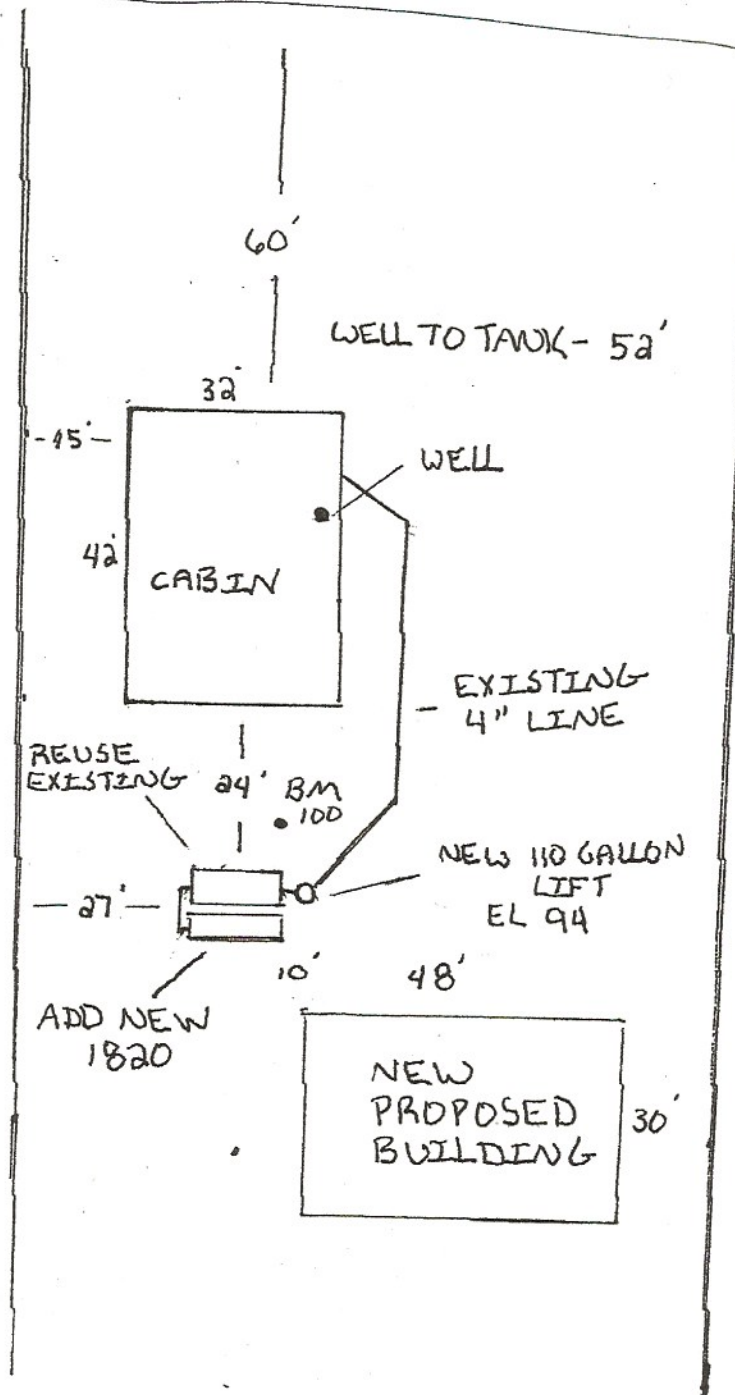

1" = 30'

Permit # \_\_\_\_\_ Address \_\_\_\_\_

THIS AGREEMENT, entered into by and between Aitkin County Registered Septic Tank Pumper, Gabley Sewer SVU, hereinafter referred to as "Contractor"; and \_\_\_\_\_, hereinafter referred to as "Homeowner".

WHEREAS, Homeowner desires and is required to retain individual sewage treatment system holding tank services to protect the environment and to obtain a certificate of compliance from Aitkin County; and

WHEREAS, the Contractor desires to provide sewage treatment system pumping services to Homeowner as necessary and in accordance with the terms and conditions outlined herein.

NOW THEREFORE, in consideration of the mutual promises contained herein, Parties do hereby agree as follows:

1. **TERM.** The term of this Agreement shall be from \_\_\_\_\_ to final installation of an Aitkin County approved sewage treatment system or connection to a Municipal Sewage Treatment System, unless earlier terminated as provided herein. The parties understand and agree that this Agreement is intended to arrange for the provision of pumping services so that Homeowner may occupy the home pursuant to a certificate of compliance to be issued by the Aitkin County Environmental Services Department upon execution of this Agreement. Homeowner further agrees that at the earliest possible date, Homeowner shall have a permanent sewage treatment system installed in accordance with the Aitkin County Individual Sewage Treatment System and Wastewater Ordinance No. 1 and as approved by the Aitkin County Environmental Services Department or connect to a Municipal Sewage Treatment System. Upon approval by the County of Aitkin of the individual sewage treatment system or connection to a municipal sewer, or approval by Aitkin County Environmental Services of an amended or different contract, this Agreement shall terminate.

2. **FREQUENCY OF PUMPING.** Homeowner agrees that he/she shall not allow the holding tank to overflow or discharge in any manner. Contractor and Homeowner agree that the holding tank shall be pumped in accordance with the following:

- Tank size (gal.) \_\_\_\_\_ / (number of household occupants multiplied by 75 gallons per day) = frequency of pumping; or
- Within 24 hours of indication by tank alarm of lack of capacity (applicable only if system has a functional alarm);
- Whichever is greater

Contractor agrees to provide pumping services according to the regular pumping schedule or as needed to prevent discharge. Homeowner shall compensate Contractor as agreed by the parties for pumping services rendered.

3. **INSPECTION.** Holding tanks will be inspected by a licensed pumper at the time of servicing for leaks below the operating depth and whether tank tops, riser joints, and connections leak through visual evidence of major defects.

4. **REPORTING.** Grievances of Homeowner or Contractor shall be reported to the Aitkin County Environmental Services Department by Homeowner or Contractor. Homeowner and Contractor understand that failure to have holding tank pumped as herein specified or the discharge of any contents from the holding tank, regardless of fault, may result in the suspension, cancellation or revocation of the certificate of compliance, and the homeowner may be required to vacate the premises.

[Signature]  
Contractor

C/O DAN SKAS  
Homeowner

Date \_\_\_\_\_

Date 11-10-19