

AITKIN COUNTY
CERTIFICATE OF INSTALLATION/~~NOTICE OF NONCOMPLIANCE~~

This certificate of installation/~~notice of noncompliance~~ has been issued this 19th day of June, 2020 to certify compliance/~~noncompliance~~ with Aitkin County's Subsurface Sewage Treatment System Ordinance.

The premises covered by this certificate are legally described as: Lots 15 & 16
Hassman Acres

Section 10 Township 46 Range 25 Lake Long

PERMIT NO. 44783 Owner Name James & Erin Gaines

Address 30956 326th Ln Aitkin, Mn 56431

Installer Name Liljenquist

Type of System Inspected Type II Holding Tanks

Parcel Number 09-1-085600/09-1-085700

The certificate of installation/~~notice of noncompliance~~ was based on No 1 of the following:

- 1) Inspection of the installation or construction as in accordance with the above referenced permit and application design.

- 2) Review of as-built plans submitted in accordance with Subdivision 9.2 D of Aitkin County's Subsurface Sewage Treatment System Ordinance.

If the above permitted subsurface sewage treatment system is in noncompliance with Aitkin County's Subsurface Sewage Treatment System Ordinance, then the following shall serve as a Notice of Violation:

- 1) Statement of the findings of fact through inspections or investigations:

- 2) List of specific violations of Ordinance: _____

- 3) Requirements for correction or removal of violations: _____

- 4) Time schedule for compliance: _____

Failure to correct or remove the above violation(s) will result in this matter being turned over to the Aitkin County Attorney's Office for further legal action, which may result in revocation of licenses, fines and/or imprisonment.

INSPECTOR SIGNATURE 

**SUBSURFACE SEWAGE TREATMENT SYSTEM INSPECTION FORM
AITKIN COUNTY, MINNESOTA**

Township Glen Date of Inspection 6-19-2020 - Lift App. Number 2019-005337
11-14-19 HT

Owner James & Erin Gaines Parcel Number 09-1-085600/09-1-085700

Project Address 30956 326th Ln Installer Liljenquist

City Aitkin Zip Code 56431

New Repair

SETBACKS:

Buildings to tank(s) 22'
 Buildings to drainfield _____
 Well(s) 50' or 100' 53 - HT 55 - Lift
 Lake/Creek/Wetland 2100'

SEPTIC TANKS:

New Existing 1-1500
 Number of tanks installed 1 Jacobson
 Liquid capacity and type 1820 precast
 Type of baffle Plastic
 Inspection pipes 6"
 Manholes size 2 @ 24"
 Manhole to grade Yes No _____

PUMPS:

New Existing _____
 Tank capacity and type 110 Lift
 Pump manufacturer & model # Reuse Existing
 Horsepower & GPM _____
 Feet of head 5
 Gallons per cycle 20
 Size of discharge line 2"
 Type & location of alarm Elc @ Tank
 Water meter _____

DIST. or DROP BOX & TYPE _____


TRENCHES, BEDS, OR GRAVELLESS LEACHFIELD:

Trench/Bed depth _____
 Trench/Bed length _____
 Trench/Bed bottom width _____
 Trench spacing _____
 Drainfield rock below pipe _____
 Size of gravelless pipe _____
 Depth of backfill _____
 Absorption area: square feet _____
 lineal feet _____

MOUNDS:

Percent slope _____
 Upslope sand width _____
 Downslope sand width _____
 Sideslope sand width _____
 Drainfield rock below pipe _____
 Depth of sand below rock _____
 Perforation size & spacing _____
 Pipe size & spacing _____
 Dimensions of rock bed _____
 Dimensions of sand base _____
 Final cover _____

DRAWING OF SYSTEM: (include soils)

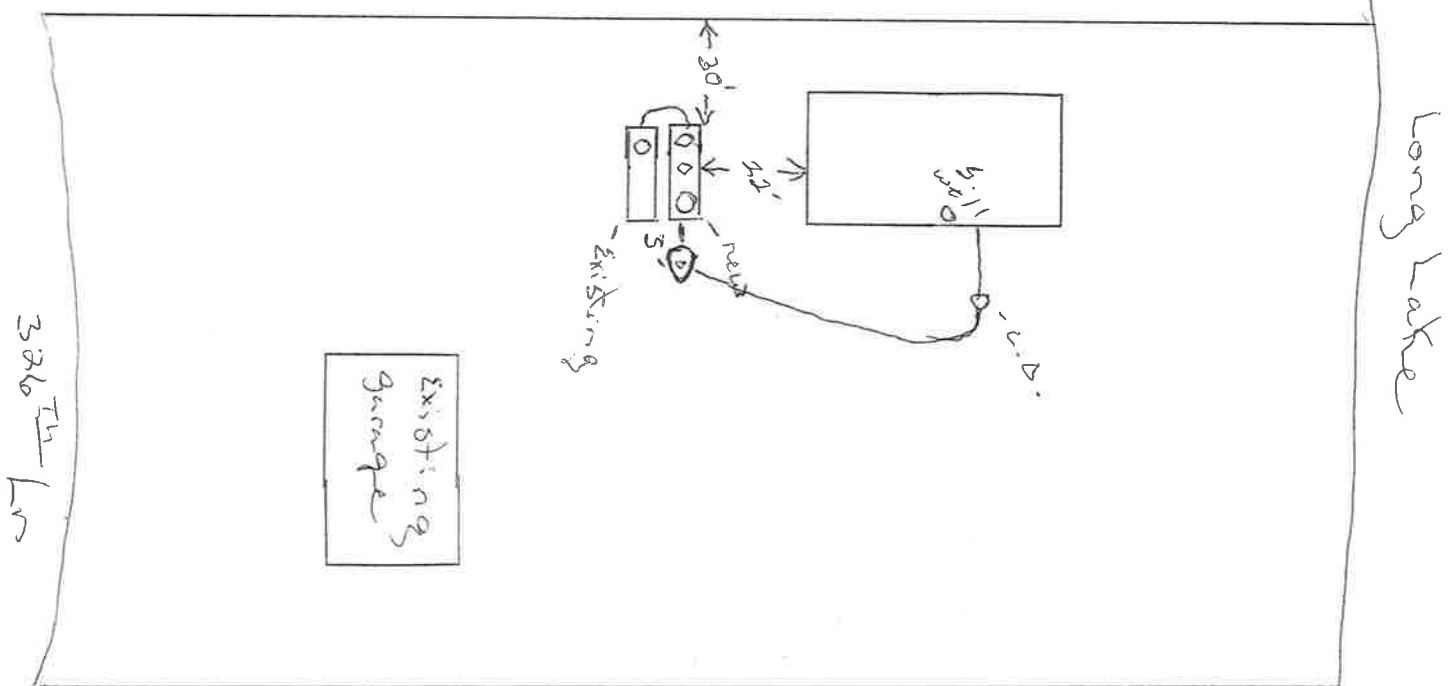

Inspector's Comments: _____

Inspector's Signature [Signature] Installer's Signature [Signature]