


**CERTIFICATE OF SURVEY**  
 OF LOT 123, SHESHEBE POINT  
 AITKIN COUNTY, MINNESOTA

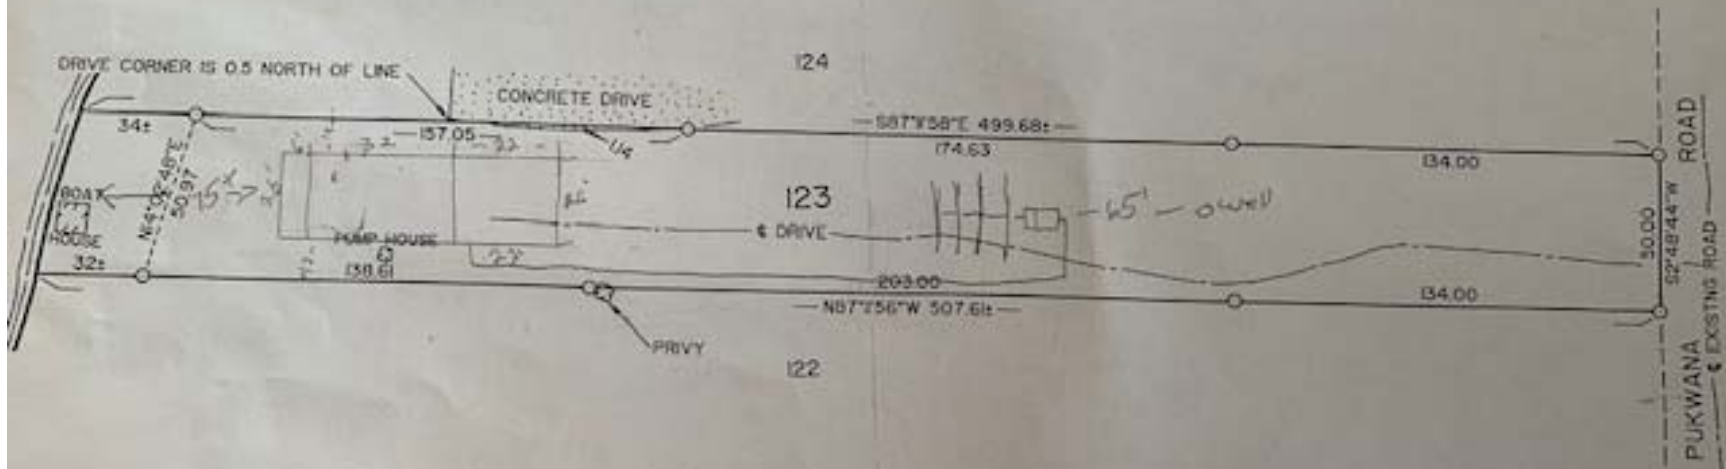

0 50  
 1 INCH = 50 FEET  
 IN MONUMENT ESTABLISHED  
 IN MONUMENT EXISTING

MARVIN KOHOUT  
 REGISTERED LAND SURVEYOR  
 PO BOX 384  
 AITKIN MN 56431-0384  
 1-500-730-6673 OR  
 218-768-2089