
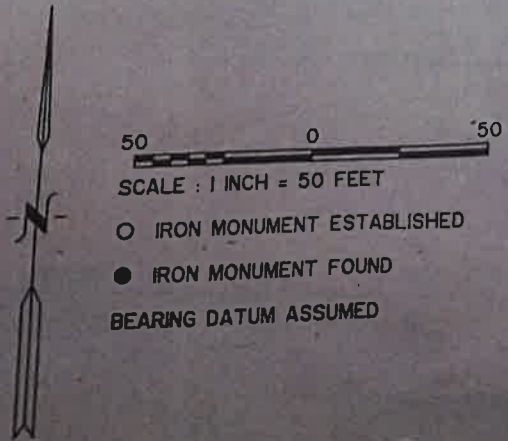


CERTIFICATE OF SURVEY
 OF LOT 123, SHESHEBE POINT
 AITKIN COUNTY, MINNESOTA

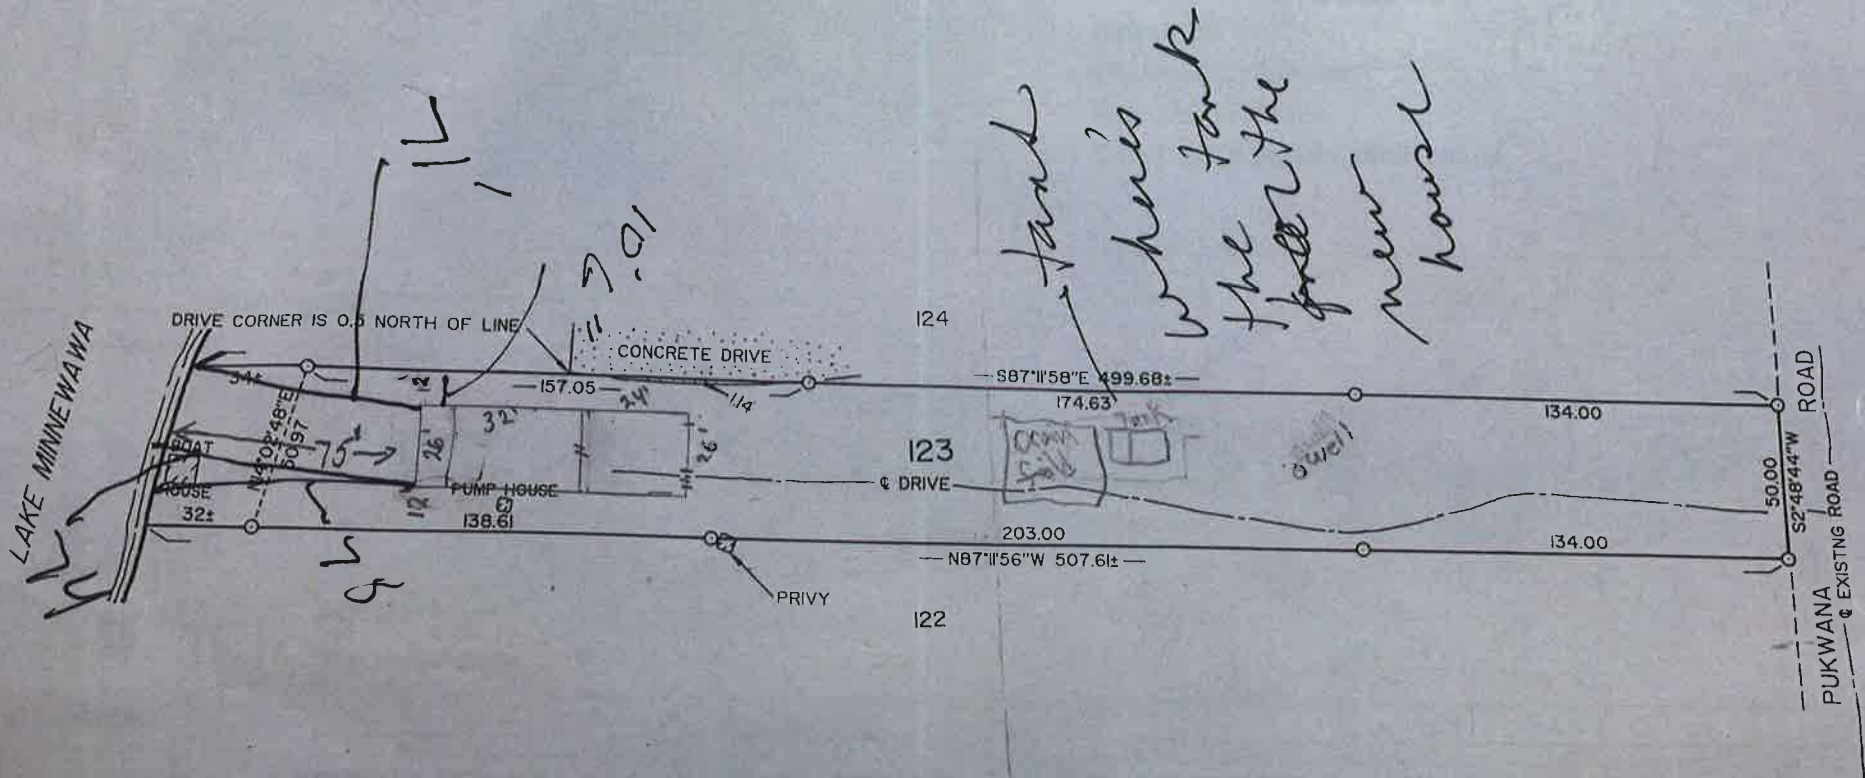

MARVIN KOHOUT
 REGISTERED LAND SURVEYOR
 PO BOX 384
 AITKIN MN 56431-0384
 1-500-730-6673 OR
 218-768-2089

I HEREBY CERTIFY THAT THIS SURVEY
 PREPARED BY ME OR UNDER MY DIRECTION
 THAT I AM A DULY REGISTERED LAND SURVEYOR
 LAWS OF THE STATE OF MINNESOTA

Marvin R. Kohout
 20.1.13