

AITKIN COUNTY
CERTIFICATE OF INSTALLATION/~~NOTICE OF NONCOMPLIANCE~~

This certificate of installation/~~notice of noncompliance~~ has been issued this 4th day of May, 2020 to certify compliance/~~noncompliance~~ with Aitkin County's Subsurface Sewage Treatment System Ordinance.

The premises covered by this certificate are legally described as: 5ac in SW corner of SW NW

Section 25 Township 43 Range 22 Lake _____

PERMIT NO. 44904 Owner Name Alex & Ashlee Hagman

Address 11500 110th Ave Finlayson, Mn 55735

Installer Name Roberts Excavating

Type of System Inspected Type I tank replacement

Parcel Number 34-0-040702

The certificate of installation/~~notice of noncompliance~~ was based on No 1 of the following:

- 1) Inspection of the installation or construction as in accordance with the above referenced permit and application design.

- 2) Review of as-built plans submitted in accordance with Subdivision 9.2 D of Aitkin County's Subsurface Sewage Treatment System Ordinance.

If the above permitted subsurface sewage treatment system is in noncompliance with Aitkin County's Subsurface Sewage Treatment System Ordinance, then the following shall serve as a Notice of Violation:

- 1) Statement of the findings of fact through inspections or investigations:

2) List of specific violations of Ordinance: _____

3) Requirements for correction or removal of violations: _____

4) Time schedule for compliance: _____

Failure to correct or remove the above violation(s) will result in this matter being turned over to the Aitkin County Attorney's Office for further legal action, which may result in revocation of licenses, fines and/or imprisonment.

INSPECTOR SIGNATURE 

**SUBSURFACE SEWAGE TREATMENT SYSTEM INSPECTION FORM
AITKIN COUNTY, MINNESOTA**

Township Wagner Date of Inspection 5-4-2020 App. Number 2020-005531

Owner Alex & Ashlee Hagman Parcel Number 34-0-040702

Project Address 11540 115th Ave Installer Roberts Excavating

City Finlayson Zip Code 55735

New Repair

SETBACKS:

Buildings to tank(s) 28'
Buildings to drainfield 65'
Well(s) 50' or 100' > 100'
Lake/Creek/Wetland —

SEPTIC TANKS: New Existing
Number of tanks installed 1 Knife River
Liquid capacity and type 1500 precast
Type of baffle Plastic
Inspection pipes —
Manholes size 2 @ 24"
Manhole to grade Yes No

PUMPS: New Existing
Tank capacity and type 1400s Precast
Pump manufacturer & model # Gould - Existing
Horsepower & GPM 1/2 50 - from previous
Feet of head 15 - current
Gallons per cycle 180
Size of discharge line 2"
Type & location of alarm Elec in Residence
Water meter —

DIST. or DROP BOX & TYPE _____


TRENCHES, BEDS, OR GRAVELLESS LEACHFIELD:

Trench/Bed depth _____
Trench/Bed length _____
Trench/Bed bottom width _____
Trench spacing _____
Drainfield rock below pipe _____
Size of gravelless pipe _____
Depth of backfill _____
Absorption area: square feet _____
lineal feet _____

MOUNDS: Existing Compliant Mound

Percent slope _____
Upslope sand width _____
Downslope sand width _____
Sideslope sand width _____
Drainfield rock below pipe _____
Depth of sand below rock _____
Perforation size & spacing _____
Pipe size & spacing _____
Dimensions of rock bed _____
Dimensions of sand base _____
Final cover _____

DRAWING OF SYSTEM: (include soils)

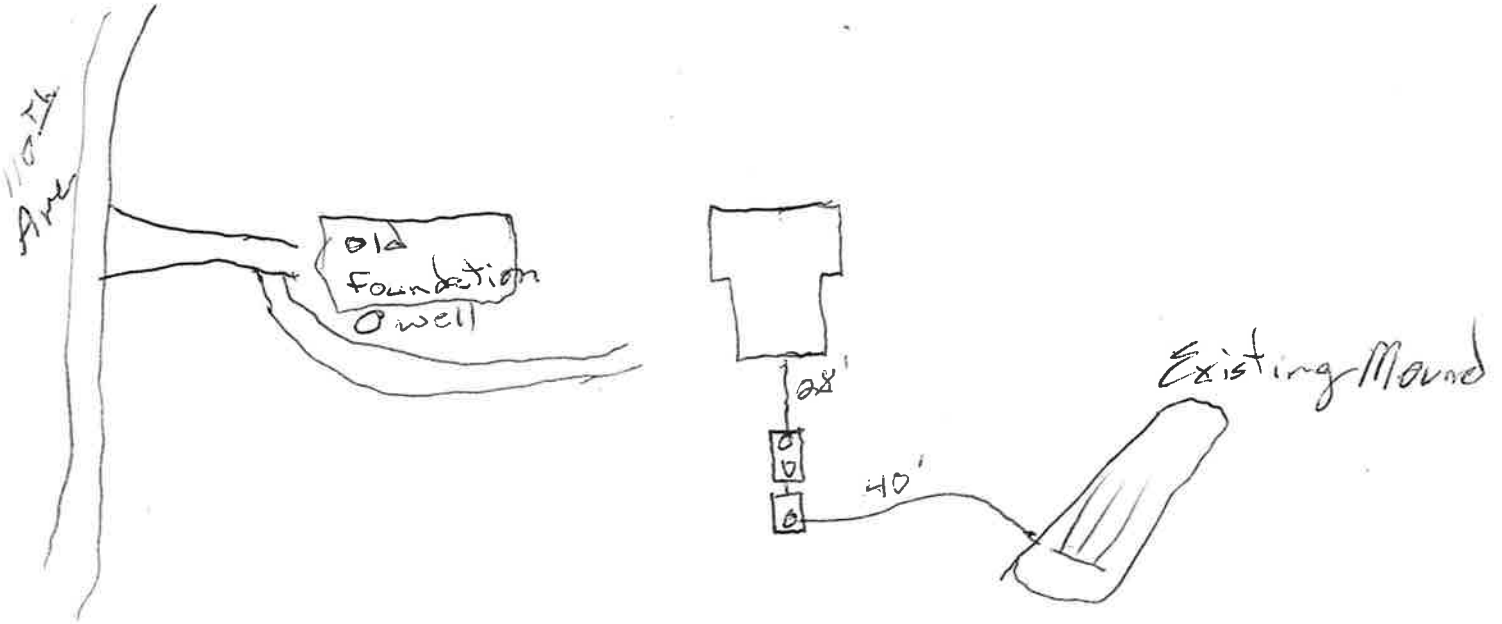

Inspector's Comments: _____

Inspector's Signature [Signature]

Installer's Signature [Signature]