


MARK  
BORN  
2020 - 005617

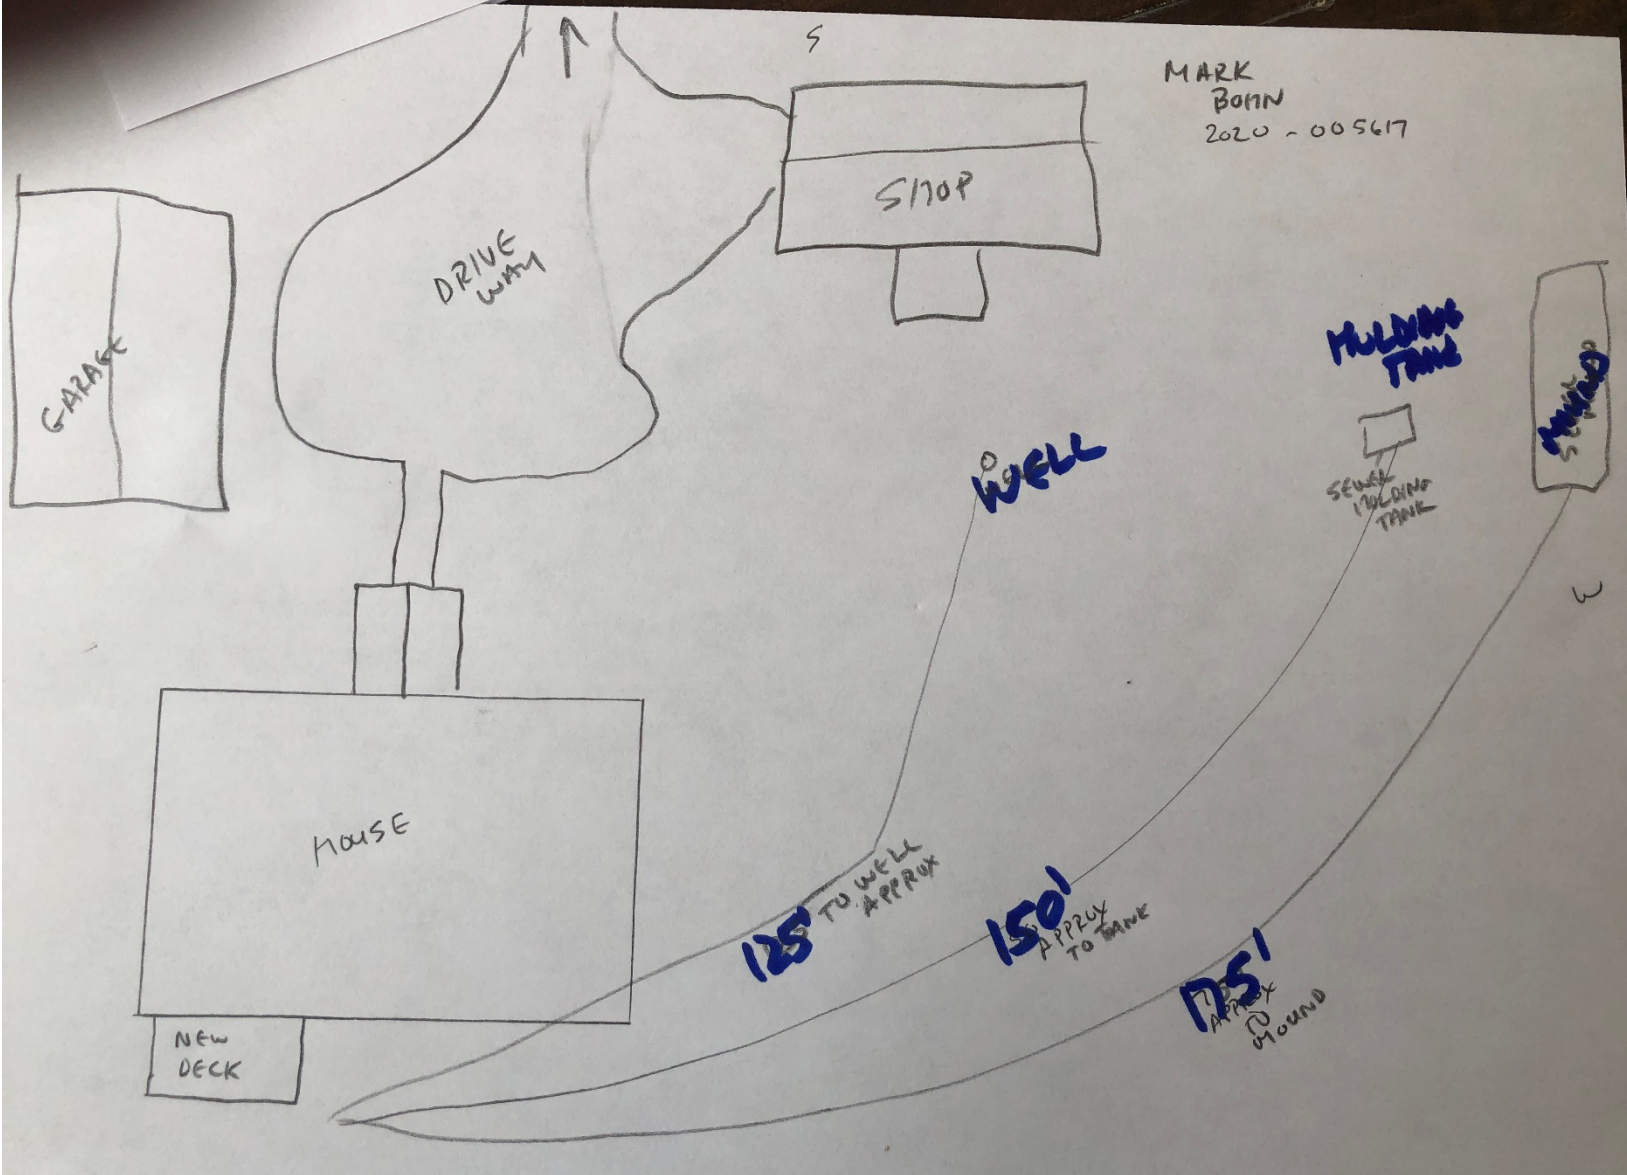

GARAGE

DRIVE WAY

SHOP

HOUSE

NEW DECK

WELL

HOLDING TANK

SEWER HOLDING TANK

HOLDING TANK

125' TO WELL APPROX

150' APPROX TO TANK

175' APPROX TO BOUND