


Please Draw to Scale with North Arrow to top or Left Side of Page

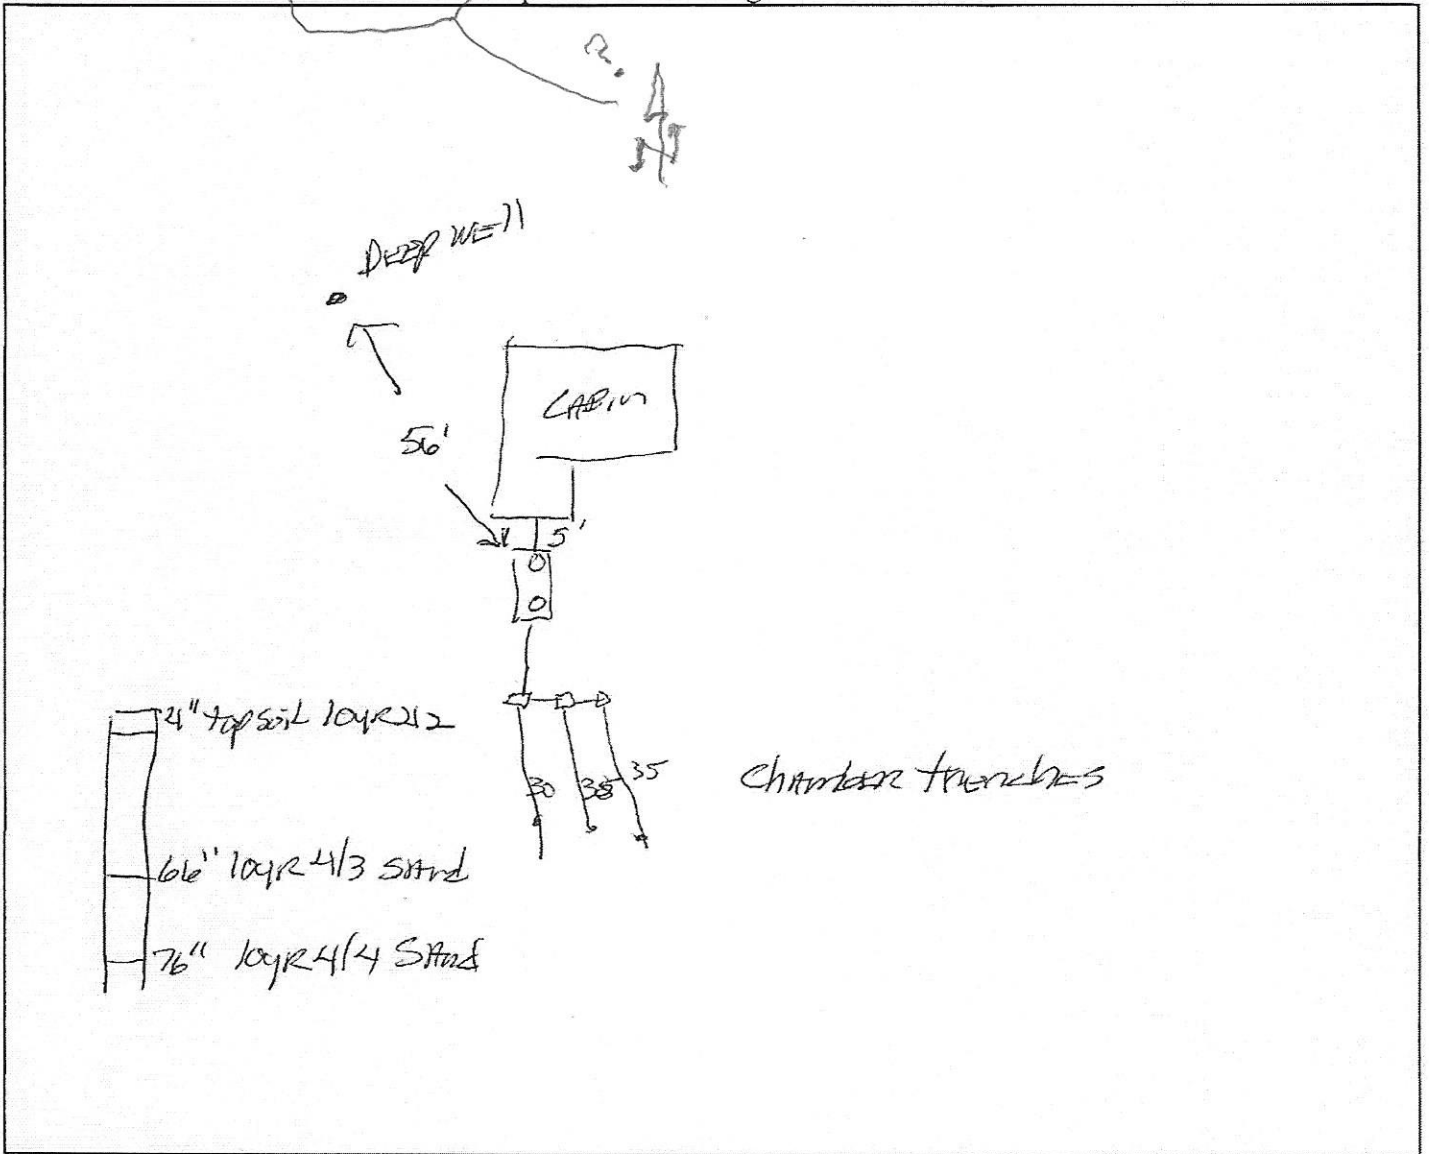

**Please show all that apply (Existing or Proposed):**

- |   |                           |                                   |
|---|---------------------------|-----------------------------------|
| Wells within 100 ft. of a Drainfield      | Disturbed/Compacted Areas | Access Route for Tank Maintenance |
| Water lines within 10 ft. of a Drainfield | Component Location        | Property Lines                    |
| Drainfield Areas                          | OHW                       | Structures                        |
| Boring Locations                          | Lot Easements             | Setbacks                          |

**Elevations:**

- |                                   |                              |
|-----------------------------------|------------------------------|
| Benchmark Elevation:              | Pump Elevation:              |
| Elevation of Sewer Line at House: | Pump Discharge Elevation:    |
| Tank Inlet Elevation:             | Restricting Layer Elevation: |
| Drainfield Elevation:             |                              |

Designer Signature: Tom [Signature]  
Date: 5/10/20

License Number:

Subject: RE: RE:  
From: troy rhodes <troy.rhodes@outlook.com>  
Date: 5/13/2020, 9:38 AM  
To: "sanderso@paulbunyan.net" <sanderso@paulbunyan.net>

Attached is a drawing and the certification I just got on the septic system. Within the certification doc, there is a nice sketch of the tank and drainfield layout.

Thanks and please let me know you are in receipt of this email and those I sent yesterday, so I know I sent to the correct email address.

Troy

Sent from Outlook

From: troy rhodes <troy.rhodes@outlook.com>  
Sent: Tuesday, May 12, 2020 6:49 PM  
To: sanderso@paulbunyan.net <sanderso@paulbunyan.net>  
Subject: RE:

Please confirm when you get this email so I know I sent to the correct email address.

Thank you,  
Troy

Sent from Mail for Windows 10

From: troy rhodes <troy.rhodes@outlook.com>  
Sent: Tuesday, May 12, 2020 6:36:34 PM  
To: sanderso@paulbunyan.net <sanderso@paulbunyan.net>  
Subject: FW:

Hi,

As we discussed over the phone, I built the cabin addition seen in the attached photos (just the 12x12 room sticking off the back) last fall, and I am wanting to pull a permit with Aitkin county. I had the septic tank inspected so I could pull the permit, and they told me where the tank was located, which you can see in the second photo attached, is just under 3 feet from the wall of the addition. There is no slab, footings or block walls beneath the surface. The addition sits on top of a stack of cinder blocks. Sorry if the photos came out sideways. I can try and re-send if these don't work for you.

Reply from zoning at Aitkin referred me to you, indicating that if an engineer signs off that the addition is of no concern regarding the septic tank, we can move forward with the permit.

Therefore, please take a look at the photos and let me know if you need any additional info to make a determination that I can share with Aitkin county zoning.

Thanks  
Troy Rhodes  
(852) 888-4019

Sent from Mail for Windows 10

From: troy.rhodes  
Sent: Tuesday, May 12, 2020 6:29 PM  
Re: troy.rhodes  
Subject:



HSE. VIEW LOOKING NORTH? NEW WING, AT LEFT

APPENDIX P PAGE P1



PHOTO AT TANK VENT WITH MEAS. TAPE.



Sent from Outlook Mobile

Attachments  
Rhodes, Troy Compliance Inspection.pdf  
addition plan.docx

LOOKING NO? AT NEW HSE. WING, SEPTIC TANK  
VENT IN FRNT OF THE DOOR.

1.8 MB  
28.3 KB

APPENDIX PAGE P2