AITKIN COUNTY	
CERTIFICATE OF INSTALLATION/NOTICE OF NONCOMPLIANCE	

This certificate of installation/notice of noncompliance has been issued this							
day of, 20 to certify compliance\ noncompliance with Aitkin County's Subsurface Sewage Treatment System Ordinance.							
Aitkin County's Subsurface Sewage Treatment System Ordinance.							
The premises covered by this certificate are legally described as:							
Section Township Range Lake PERMIT NO Owner Name							
PERMIT NO. Owner Name							
Address							
Installer Name							
Installer Name Type of System Inspected							
Parcel Number							
The certificate of installation/ notice of noncompliance was based on No of the following:							
1) Inspection of the installation or construction as in accordance with the above							
referenced permit and application design.							
referenced permit and application design.							
2) Review of as built plans submitted in accordance with Subdivision 0.2 D of							
2) Review of as-built plans submitted in accordance with Subdivision 9.2 D of							
Aitkin County's Subsurface Sewage Treatment System Ordinance.							
If the choice normitted subsurface courses treatment eveters is in non-coursilence with							
If the above permitted subsurface sewage treatment system is in noncompliance with							
Aitkin County's Subsurface Sewage Treatment System Ordinance, then the following							
shall serve as a Notice of Violation:							
1) Statement of the findings of fact through inspections or investigations:							
2) List of specific violations of Ordinance:							
Requirements for correction or removal of violations:							
4) Time schedule for compliance:							
Failure to correct or remove the above violation(s) will result in this matter being							
turned over to the Aitkin County Attorney's Office for further legal action, which may							
result in revocation of licenses or registrations, fines and/or imprisonment.							
INSPECTOR SIGNATURE							

AITKIN COUN	TY, MINNESOTA 8/25/2020I 2020-5813			
Township <u>Shamrock</u> Date of Inspection	10/14/2020 F App. Number 45057			
Owner Erica McKay	Parcel Number <u>29-1-207000</u>			
Project Address 18478 483454	Installer Jerry Farley			
City McGaregor Zip Code 557	TI 3BR PB			
New Repair	DIST. or DROP BOX & TYPE			
SETBACKS:	TRENCHES, BEDS, OR GRAVELLESS LEACHFIELD:			
Buildings to tank(s) $\underline{\mathcal{HO}}$	Trench/Bed depth(2 "			
Buildings to drainfield _/ 00 ' +	Trench/Bed length			
Well(s) 50' or 100'_ <u>\$W</u> ; 50 '+	Trench/Bed bottom width 14'			
Lake/Creek/Wetland Lake, Minnewawa: 100+	French spacing 5 Laterals (3' gp.			
	Drainfield rock below pipe'			
SEPTIC TANKS: New/_ Existing	Size of gravelless pipe			
Number of tanks installed (1) 1650 Tac. Combo	Depth of backfill <u><i>l</i></u> 2"			
Liquid capacity and type <u>1120 part combo</u>	Absorption area: square feet $574 ft^2$			
Type of bafflePlastic	lineal feet			
Inspection pipes	MOUNDS:			
Manholes size 24"	Percent slope			
Manhole to grade Yes 🔽 No 📃	Upslope sand width			
	Downslope sand width			
PUMPS: New Existing	Sideslope sand width			
Tank capacity and type part comes	Drainfield rock below pipe/			
Pump manufacturer & model # Zoeller 153	Depth of sand below rock/			
Horsepower & GPM <u>0.5HP</u> 5ZGPM	Perforation size & spacing			
Feet of head <u>27'</u>	Pipe size & spacing $1.5''(36''_{SP})$			
Gallons per cycle <u>113 GPC</u>	Dimensions of rock bed			
Size of discharge line/, <i>S "</i>	Dimensions of rock bed Dimensions of sand base			
Type & location of alarm <u>Elec. on tank</u>	Final cover/			
Water meter				

DRAWING OF SYSTEM: (include soils)


Inspector's Comments:

Inspector's Signature _____ Bryan Hangrave ____ Installer's Signature___

Rev:1/13

.

Site Drawing

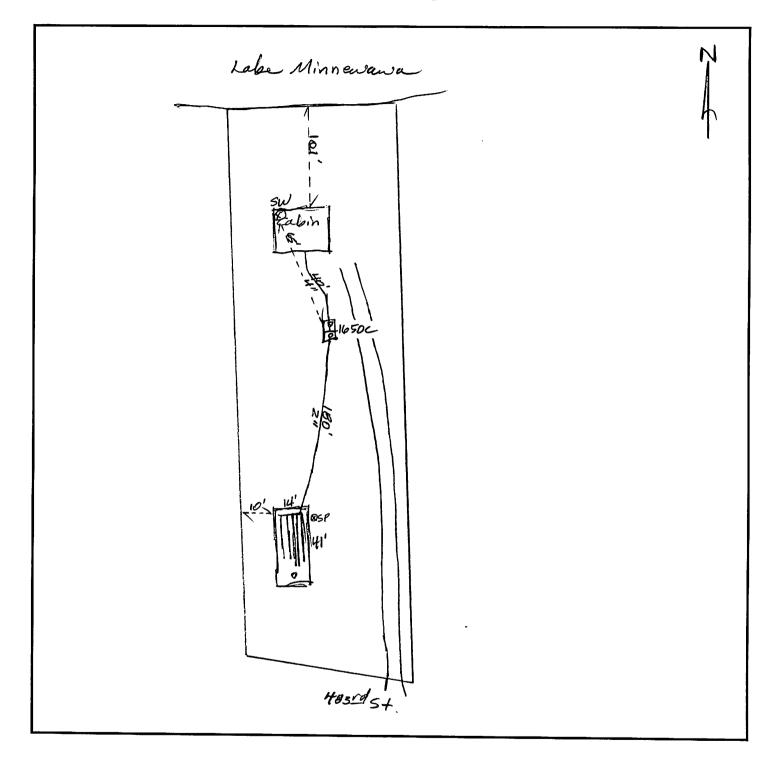

Soils				
A	Q-7"	10 YR 3/	2 25	0-5%cf
Bal	1-23"	7.5YR	1/4 5	05%cf
Buz	23-34"	7,54R41	35	0-5%cf
CI	34-47"	7.54R51	4 5	0-570cf
22	47-60"+	7.54R6/	1 5	0-570CF

