


↑ APROX 666' to 170th

NOTE 10" overhang


DRIVE WAY

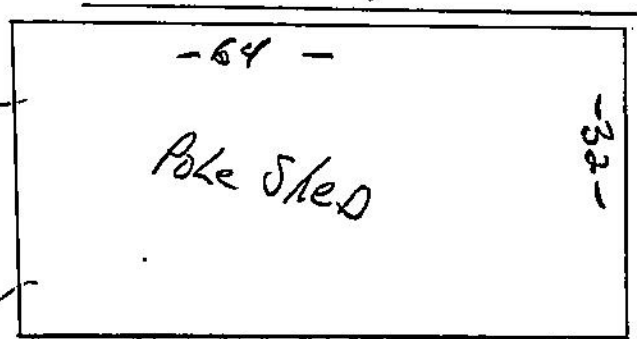

North

Large Pine Tree BENCHMARK STAB hgt.

Proposed well location

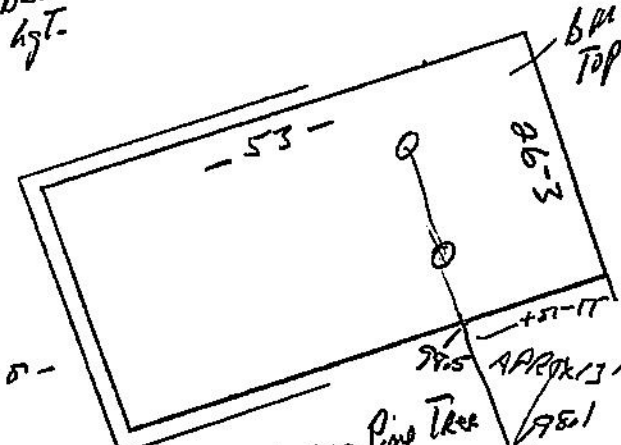


↑
↔ 200 ft to ALL Property Lines
↓

Large Pine Tree

NEW TANK

NOTE 10" overhang

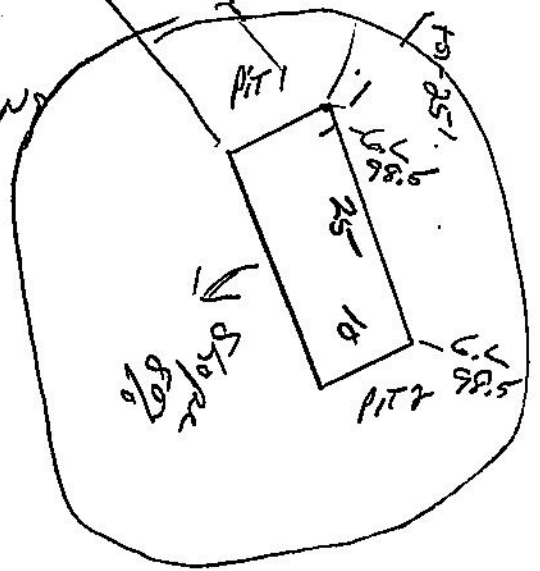

- 98.5 Line at home
- 98.1 TANK in lot
- 95.5 Pump E.L.V.
- 101.4 Discharge height
- 5.9 Pump Dist. height.