

6 + 25' Lots 130ft Deep  
1" 40'

P.L. - By Owners

James Frankel


64891 426th Pl

Statata, Mn 55485

S 34-52-26 R

No well

1" = 40' → North

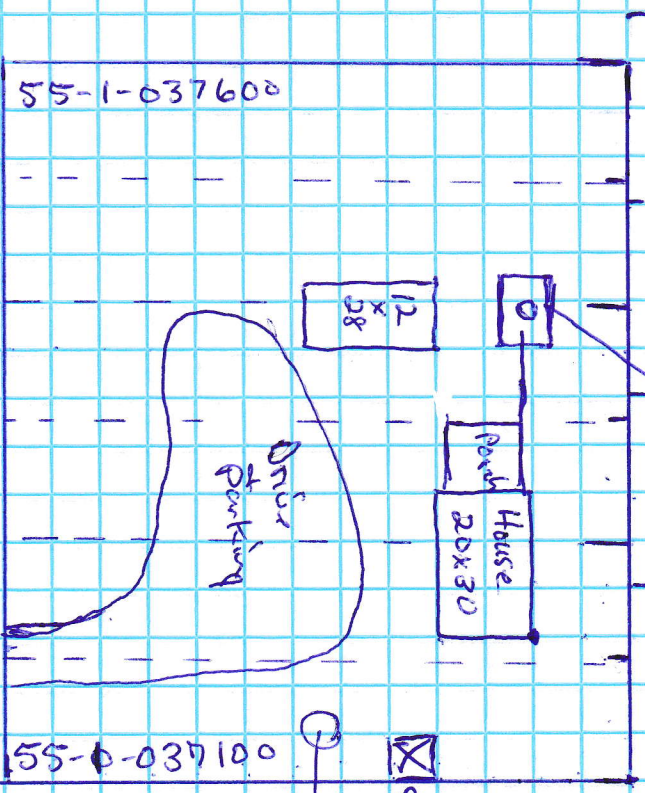

Dave Rye #1174

Sept Design + layout  
4/21/2020