

AITKIN COUNTY
CERTIFICATE OF INSTALLATION/~~NOTICE OF NONCOMPLIANCE~~

This certificate of installation/~~notice of noncompliance~~ has been issued this _____ day of _____, 20____ to certify compliance/~~noncompliance~~ with Aitkin County's Subsurface Sewage Treatment System Ordinance.

The premises covered by this certificate are legally described as: _____

Section _____ Township _____ Range _____ Lake _____
PERMIT NO. _____ Owner Name _____
Address _____
Installer Name _____
Type of System Inspected _____
Parcel Number _____

The certificate of installation/~~notice of noncompliance~~ was based on No ___ of the following:

- 1) Inspection of the installation or construction as in accordance with the above referenced permit and application design.

- 2) Review of as-built plans submitted in accordance with Subdivision 9.2 D of Aitkin County's Subsurface Sewage Treatment System Ordinance.

If the above permitted subsurface sewage treatment system is in noncompliance with Aitkin County's Subsurface Sewage Treatment System Ordinance, then the following shall serve as a Notice of Violation:

- 1) Statement of the findings of fact through inspections or investigations:

- 2) List of specific violations of Ordinance: _____

- 3) Requirements for correction or removal of violations: _____

- 4) Time schedule for compliance: _____

Failure to correct or remove the above violation(s) will result in this matter being turned over to the Aitkin County Attorney's Office for further legal action, which may result in revocation of licenses or registrations, fines and/or imprisonment.

INSPECTOR SIGNATURE _____

**SUBSURFACE SEWAGE TREATMENT SYSTEM INSPECTION FORM
AITKIN COUNTY, MINNESOTA**

Township Shawrock Date of Inspection 7/17/2020 App. Number 45235
 Owner Mary Enger Fish Parcel Number 29-1-482700
 Project Address 48746 166th Ave. Installer Jerry Farley
 City McGregor Zip Code 55760 TZ HT (2)

New Repair

DIST. or DROP BOX & TYPE _____

SETBACKS:

TRENCHES, BEDS, OR GRAVELLESS LEACHFIELD:

Buildings to tank(s) 30'+
 Buildings to drainfield -
 Well(s) 50' or 100' SW: 50'+60' (neighbor)
 Lake/Creek/Wetland -

Trench/Bed depth _____
 Trench/Bed length _____
 Trench/Bed bottom width _____
 Trench spacing _____
 Drainfield rock below pipe _____
 Size of gravelless pipe _____
 Depth of backfill _____
 Absorption area: square feet _____
 lineal feet _____

SEPTIC TANKS: New Existing

MOUNDS:

Number of tanks installed (2) In Filterator
 Liquid capacity and type 1500
 Type of baffle Plastic

Percent slope _____
 Upslope sand width _____
 Downslope sand width _____
 Sideslope sand width _____
 Drainfield rock below pipe _____
 Depth of sand below rock _____
 Perforation size & spacing _____
 Pipe size & spacing _____
 Dimensions of rock bed _____
 Dimensions of sand base _____
 Final cover _____

Inspection pipes _____


Manholes size 24"

Manhole to grade Yes No

PUMPS: New Existing

Tank capacity and type _____
 Pump manufacturer & model # _____
 Horsepower & GPM _____
 Feet of head _____
 Gallons per cycle _____
 Size of discharge line _____
 Type & location of alarm Manual Alarm
 Water meter _____

DRAWING OF SYSTEM: (include soils)

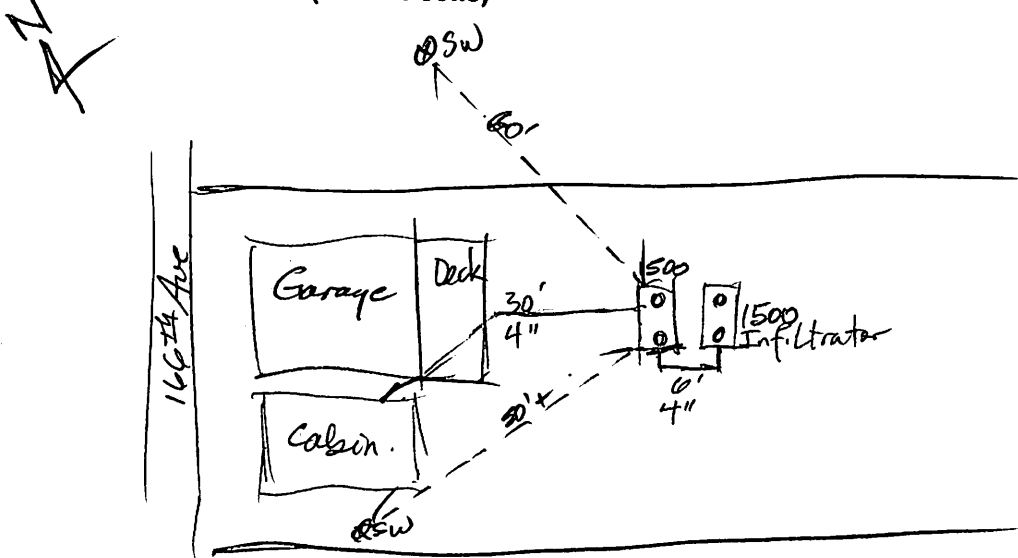

Inspector's Comments: No room for TI system due to 30' 4"

Inspector's Signature Bryan Hargrave Installer's Signature _____



2020/07/17



2020/07/17



2020/07/17