


Aitkin County { Holding Tank Design }

Property Owner:
One Inch = 40 ft.

Gayle Berger

Date: 7/14/2020

Designer's Initials : JB

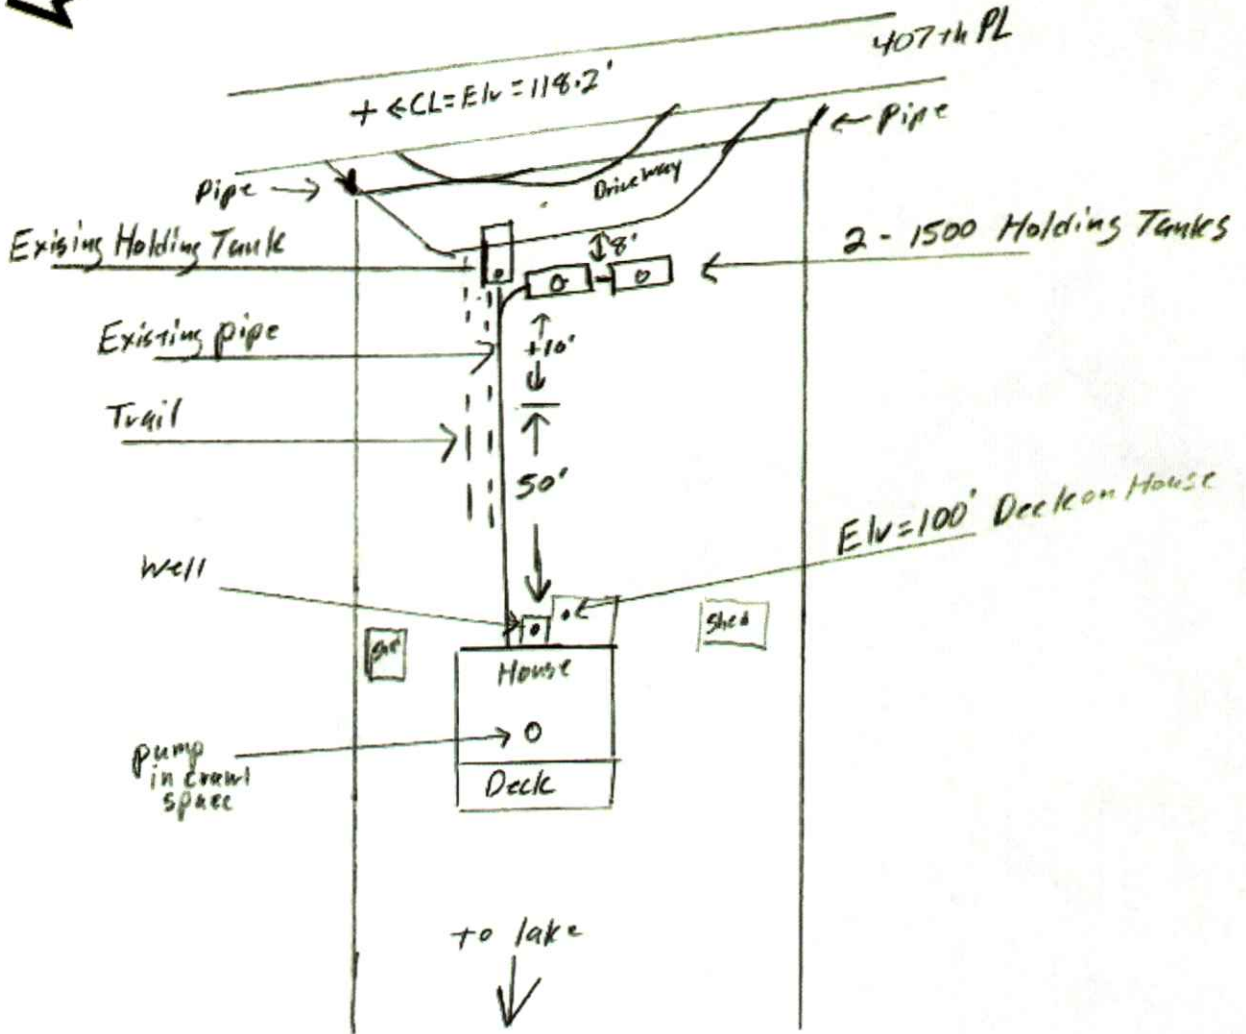

Please show all that apply (Existing or Proposed): Please Draw to Scale with North to Top or Left Side of Page:

Wells within 100ft. Of Drain field.	Disturbed/Compacted Areas	Access Route for Tank Maintenance
Water lines within 10 ft. of Drain field.	Component Location	Property Lines
Drain field Areas:	OHW ordinary high water	Structures
	Lot Easements	Setbacks

Elevations :	Benchmark Elevation:	Elv. = 100' Front deck towards road near well dog house
Spirits Lake Elv. =	Approx. 75'	Grade at Proposed Holding Tanks Elv. = 113.1'
Existing Holding Tank Inlet Elv. =	111.7'	Proposed 1st H- tank inlet Elv. = 111.5'
Grade at Existing H- tank location Elv. =	114.2'	Proposed 2nd H- tank Inlet Elv. = 111'
Grade at Center line of road Elv. =	118.2'	Approx. Pump Elv. = 95.2'