

AITKIN COUNTY
CERTIFICATE OF INSTALLATION/~~NOTICE OF NONCOMPLIANCE~~

This certificate of installation/~~notice of noncompliance~~ has been issued this 29th day of September, 2020 to certify compliance/~~noncompliance~~ with Aitkin County's Subsurface Sewage Treatment System Ordinance.

The premises covered by this certificate are legally described as: PARTS OF LOTS 17, 18 & 19 S OF N 197 FT, EXC W 37.5 FT OF LOT 17 Big Sandy Highlands Fifth Addition

Section 34 Township 50 Range 23 Lake Big Sandy
PERMIT NO. 45431 Owner Name Mark & Patricia Sanford
Address 52859 Loon Ave. McGregor, Mn 55760
Installer Name Darlow Excavating
Type of System Inspected Type II Holding tank
Parcel Number 32-1-060103

The certificate of installation/~~notice of noncompliance~~ was based on No 1 of the following:

- 1) Inspection of the installation or construction as in accordance with the above referenced permit and application design.

- 2) Review of as-built plans submitted in accordance with Subdivision 9.2 D of Aitkin County's Subsurface Sewage Treatment System Ordinance.

If the above permitted subsurface sewage treatment system is in noncompliance with Aitkin County's Subsurface Sewage Treatment System Ordinance, then the following shall serve as a Notice of Violation:

- 1) Statement of the findings of fact through inspections or investigations:

- 2) List of specific violations of Ordinance: _____

- 3) Requirements for correction or removal of violations: _____

- 4) Time schedule for compliance: _____

Failure to correct or remove the above violation(s) will result in this matter being turned over to the Aitkin County Attorney's Office for further legal action, which may result in revocation of licenses, fines and/or imprisonment.

INSPECTOR SIGNATURE 

**SUBSURFACE SEWAGE TREATMENT SYSTEM INSPECTION FORM
AITKIN COUNTY, MINNESOTA**

Township Turner Date of Inspection 9-29-2020 App. Number 2020-006380

Owner Mack & Patricia Sanford Parcel Number 32-1-060103

Project Address 52859 Loan Ave Installer Darlow Excavating

City McGregor Zip Code 55760

New Repair

SETBACKS:

Buildings to tank(s) 12.5'

Buildings to drainfield No D.F.

Well(s) 50' or 100' 56'

Lake/Creek/Wetland > 100'

SEPTIC TANKS: Wieser Precast
New Existing

Number of tanks installed two existing

Liquid capacity and type N-2500 21350

Type of baffle N-Plastic

Inspection pipes N-1-4"

Manholes size 2 @ 24"

Manhole to grade Yes No

PUMPS: New Existing

Tank capacity and type ~~_____~~

Pump manufacturer & model # ~~_____~~

Horsepower & GPM ~~_____~~

Feet of head ~~_____~~

Gallons per cycle ~~_____~~

Size of discharge line ~~_____~~

Type & location of alarm float at Tank

Water meter ~~_____~~

DIST. or DROP BOX & TYPE _____

TRENCHES, BEDS, OR GRAVELLESS LEACHFIELD:

Trench/Bed depth _____

Trench/Bed length _____

Trench/Bed bottom width _____

Trench spacing _____

Drainfield rock below pipe _____

Size of gravelless pipe _____

Depth of backfill _____

Absorption area: square feet _____

lineal feet _____

MOUNDS:

Percent slope _____

Upslope sand width _____

Downslope sand width _____

Sideslope sand width _____

Drainfield rock below pipe _____

Depth of sand below rock _____

Perforation size & spacing _____


Pipe size & spacing _____

Dimensions of rock bed _____

Dimensions of sand base _____

Final cover _____

DRAWING OF SYSTEM: (include soils) holding tanks

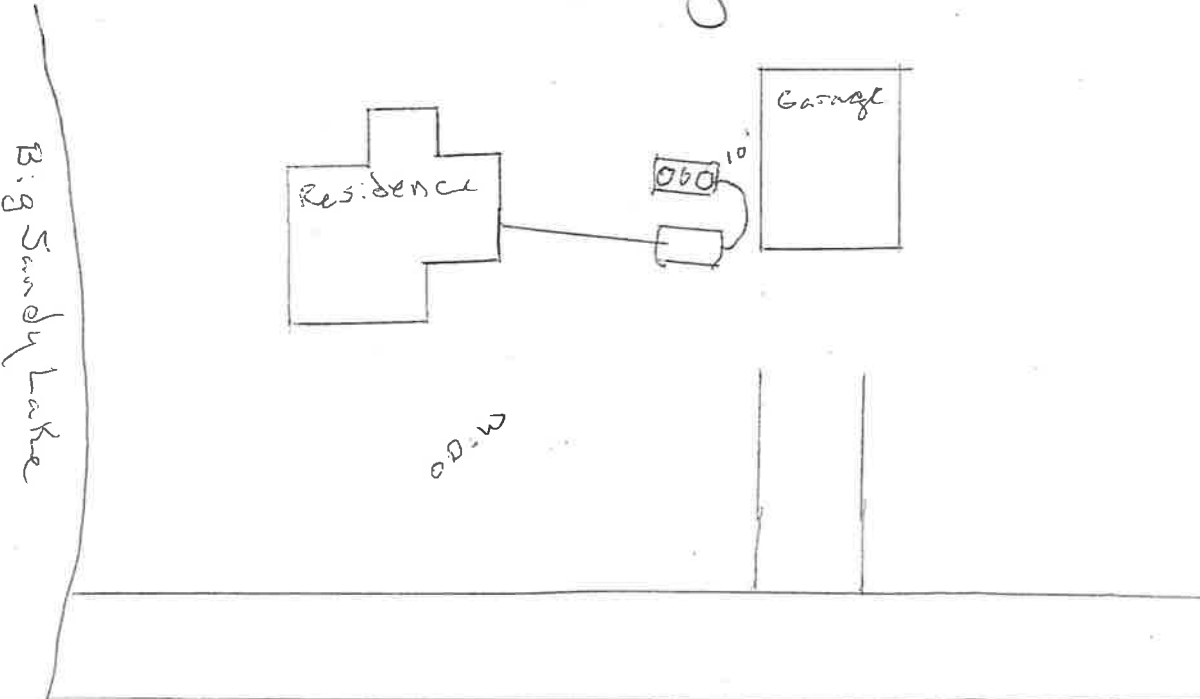

Inspector's Comments: _____

Inspector's Signature [Signature]

Installer's Signature [Signature]