

AITKIN COUNTY
CERTIFICATE OF INSTALLATION/~~NOTICE OF NONCOMPLIANCE~~

This certificate of installation/~~notice of noncompliance~~ has been issued this 25th day of September, 2020 to certify compliance/~~noncompliance~~ with Aitkin County's Subsurface Sewage Treatment System Ordinance.

The premises covered by this certificate are legally described as: Lot 1 Linden Shores

Section 16 Township 48 Range 25 Lake Wilkins

PERMIT NO. 45508 Owner Name Dave McMillan

Address 43242 310th Pl. Palisade, Mn 56469

Installer Name Kern Excavating

Type of System Inspected Type II holding tanks

Parcel Number 08-1-070000

The certificate of installation/~~notice of noncompliance~~ was based on No 1 of the following:

- 1) Inspection of the installation or construction as in accordance with the above referenced permit and application design.

- 2) Review of as-built plans submitted in accordance with Subdivision 9.2 D of Aitkin County's Subsurface Sewage Treatment System Ordinance.

If the above permitted subsurface sewage treatment system is in noncompliance with Aitkin County's Subsurface Sewage Treatment System Ordinance, then the following shall serve as a Notice of Violation:

- 1) Statement of the findings of fact through inspections or investigations:

2) List of specific violations of Ordinance: _____

3) Requirements for correction or removal of violations: _____

4) Time schedule for compliance: _____

Failure to correct or remove the above violation(s) will result in this matter being turned over to the Aitkin County Attorney's Office for further legal action, which may result in revocation of licenses, fines and/or imprisonment.

INSPECTOR SIGNATURE 

**SUBSURFACE SEWAGE TREATMENT SYSTEM INSPECTION FORM
AITKIN COUNTY, MINNESOTA**

Township Fleming Date of Inspection 9-25-2020 App. Number 2020-006425

Owner Dave McMillan Parcel Number 08-1-070000

Project Address 43242 310th Pl. Installer Kern Excavating

City Palisade Zip Code 56469

New Repair

SETBACKS:

Buildings to tank(s) No buildings yet

Buildings to drainfield Holding Tanks

Well(s) 50' or 100' No Well

Lake/Creek/Wetland 98

SEPTIC TANKS: New Existing

Number of tanks installed 2 Jacobson

Liquid capacity and type 15000 plastic

Type of baffle Plastic

Inspection pipes 2-6" Per Tank

Manholes size 2-24" Per Tank

Manhole to grade Yes No

PUMPS: New Existing

Tank capacity and type _____

Pump manufacturer & model # _____

Horsepower & GPM _____

Feet of head _____

Gallons per cycle _____

Size of discharge line _____

Type & location of alarm _____

Water meter _____

DIST. or DROP BOX & TYPE _____

TRENCHES, BEDS, OR GRAVELLESS LEACHFIELD:

Trench/Bed depth _____

Trench/Bed length _____

Trench/Bed bottom width _____

Trench spacing _____

Drainfield rock below pipe _____

Size of gravelless pipe _____

Depth of backfill _____

Absorption area: square feet _____

lineal feet _____

MOUNDS:

Percent slope _____

Upslope sand width _____

Downslope sand width _____

Sideslope sand width _____

Drainfield rock below pipe _____

Depth of sand below rock _____

Perforation size & spacing _____


Pipe size & spacing _____

Dimensions of rock bed _____

Dimensions of sand base _____

Final cover _____

DRAWING OF SYSTEM: (include soils)

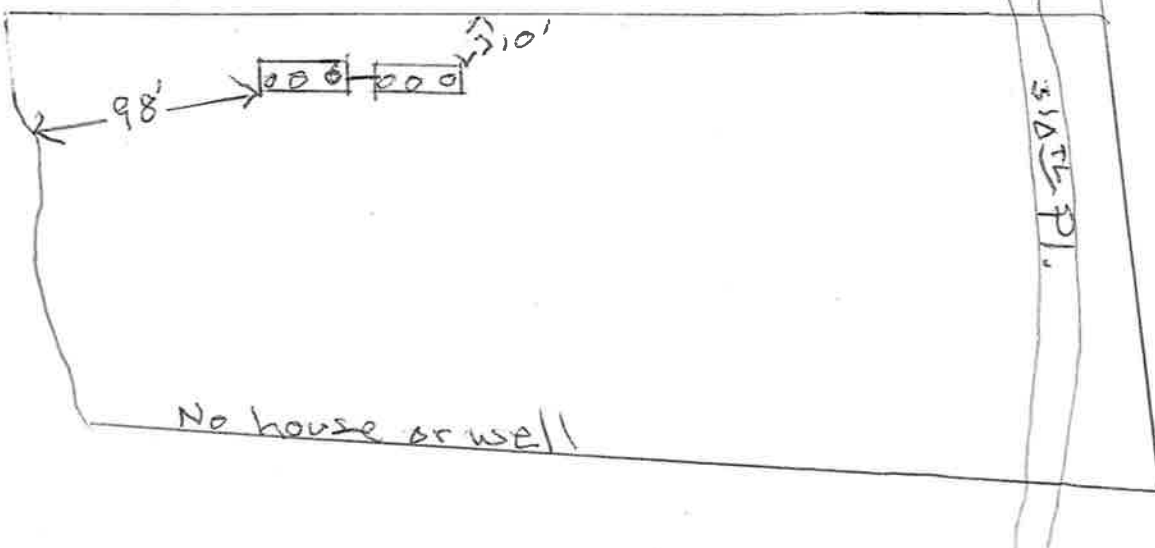

Inspector's Comments: _____

Inspector's Signature _____ Installer's Signature _____