

~~Wagner, Joseph~~  
~~Schwartz, Fredrick~~  
Route 1 Box 184A  
Sandstone, Mn. 55072

No. 8197

Wagner Iwp.  
10/22/80  
0

~~S<sup>1</sup>/<sub>2</sub> of NW<sup>1</sup>/<sub>4</sub> W<sup>1</sup>/<sub>2</sub> of SW<sup>1</sup>/<sub>4</sub>~~

34-43-22

SE NW 34-43-22




Sewer-Lewis  
1500 gal septic

600 sq ft drainfield (lift station)

Inspection- DMF 10-22-80

P. #34-0-056100

Q

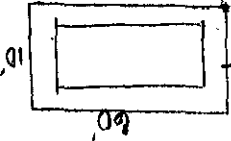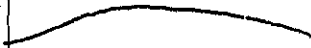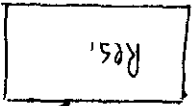

will Pump & Fill  
old tanks