

WELL OR BORING LOCATION  
County Name Aitkin

MINNESOTA DEPARTMENT OF HEALTH  
**WELL AND BORING RECORD**  
Minnesota Statutes, Chapter 103I

MINNESOTA UNIQUE WELL AND BORING NO.  
**750319**

Township Name Wagner Township No. 43 Range No. 22 Section No. 34 Fraction W 1/4 W 1/4 S 1/4


WELL/BORING DEPTH (completed) 241 ft. DATE WORK COMPLETED 5/10/07

GPS LOCATION: Latitude \_\_\_\_\_ degrees \_\_\_\_\_ minutes \_\_\_\_\_ seconds \_\_\_\_\_  
Longitude \_\_\_\_\_ degrees \_\_\_\_\_ minutes \_\_\_\_\_ seconds \_\_\_\_\_

DRILLING METHOD  
 Cable Tool  Driven  Dug  
 Auger  Rotary  Jetted

House Number, Street Name, City, and Zip Code of Well Location \_\_\_\_\_ or Fire Number \_\_\_\_\_

DRILLING FLUID Bentonite WELL HYDROFRACTURED?  Yes  No

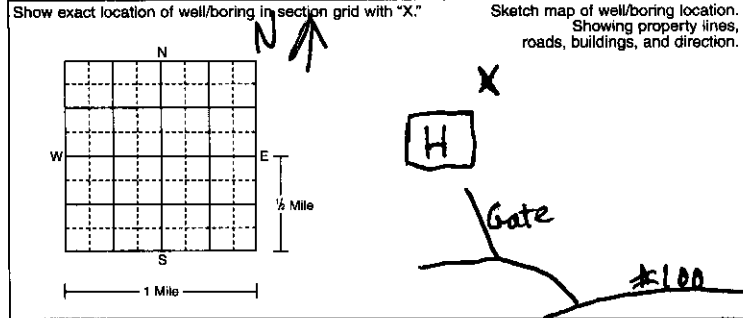

USE  Domestic  Monitoring  Heating/Cooling  
 Noncommunity PWS  Environ. Bore Hole  Industry/Commercial  
 Community PWS  Irrigation  Remedial  
 Elevator  Dewatering  \_\_\_\_\_

CASING MATERIAL  Steel  Threaded  Welded  Plastic Drive Shoe?  Yes  No HOLE DIAM. 6 3/4 in. to \_\_\_\_\_ ft.

CASING Diameter 4 in. to 233 ft. Weight \_\_\_\_\_ lbs./ft. Specifications 200 psi 6 3/4 in. to \_\_\_\_\_ ft.  
\_\_\_\_\_ in. to \_\_\_\_\_ ft. \_\_\_\_\_ lbs./ft. \_\_\_\_\_ in. to \_\_\_\_\_ ft.  
\_\_\_\_\_ in. to \_\_\_\_\_ ft. \_\_\_\_\_ lbs./ft. \_\_\_\_\_ in. to \_\_\_\_\_ ft.

PROPERTY OWNER'S NAME/COMPANY NAME Northern Contractors Inc.

SCREEN Make Johnson OPEN HOLE From 2" ft. To \_\_\_\_\_ ft.  
Type SS Diam. \_\_\_\_\_

Property owner's mailing address if different than well location address indicated above.  
Po Box 273  
Finlayson MN 55735

Slot/Gauze .015 Length 8'  
Set between 233 ft. and 241 ft. FITTINGS \_\_\_\_\_

WELL OWNER'S NAME/COMPANY NAME Same

STATIC WATER LEVEL 50 ft. Below  Above land surface Measured from 5/10/07

Well/boring owner's mailing address if different than property owner's address indicated above.

PUMPING LEVEL (below land surface) \_\_\_\_\_ ft. after \_\_\_\_\_ hrs. pumping 20 g.p.m.

GEOLOGICAL MATERIALS	COLOR	HARDNESS OF MATERIAL	FROM	TO
Clay	reddish		0	13
gravel	"		13	35
Clay	"		35	108
clay + sand	"		108	120
Clay	"		120	200
gravel	"		200	241

WELLHEAD COMPLETION  
 Pitless/adaptor manufacturer \_\_\_\_\_ Model \_\_\_\_\_  
 Casing Protection  12 in. above grade  
 At-grade (Environmental Well and Boring ONLY)

GROUTING INFORMATION  
Well grouted  Yes  No  
Grout materials  Neat cement  Bentonite  Concrete  Other \_\_\_\_\_  
From 0 To 30 ft. \_\_\_\_\_ Yds. \_\_\_\_\_ Bags  
From \_\_\_\_\_ To \_\_\_\_\_ ft. \_\_\_\_\_ Yds. \_\_\_\_\_ Bags  
From \_\_\_\_\_ To \_\_\_\_\_ ft. \_\_\_\_\_ Yds. \_\_\_\_\_ Bags

NEAREST KNOWN SOURCE OF CONTAMINATION \_\_\_\_\_ feet \_\_\_\_\_ direction \_\_\_\_\_ type

Well disinfected upon completion?  Yes  No

PUMP  Not installed Date installed 5/16/07

Manufacturer's name \_\_\_\_\_ Model Number \_\_\_\_\_ HP \_\_\_\_\_ Volts \_\_\_\_\_

Length of drop pipe \_\_\_\_\_ ft. Capacity \_\_\_\_\_ g.p.m.  
Type:  Submersible  L.S. Turbine  Reciprocating  Jet  \_\_\_\_\_

ABANDONED WELLS Does property have any not in use and not sealed well(s)?  Yes  No

VARIANCE Was a variance granted from the MDH for this well?  Yes  No TN# \_\_\_\_\_

WELL CONTRACTOR CERTIFICATION  
This well was drilled under my supervision and in accordance with Minnesota Rules, Chapter 4725. The information contained in this report is true to the best of my knowledge.

REMARKS, ELEVATION, SOURCE OF DATA, etc.



Boart Longyear 2022 Licensee Business Name Lic. or Reg. No.

Tom [Signature] 429 5/16/07 Certified Representative Signature Certified Rep. No. Date

Randy Hamm Name of Driller

MINN. DEPT. OF HEALTH COPY 750319