


DIG SANDY LAKE

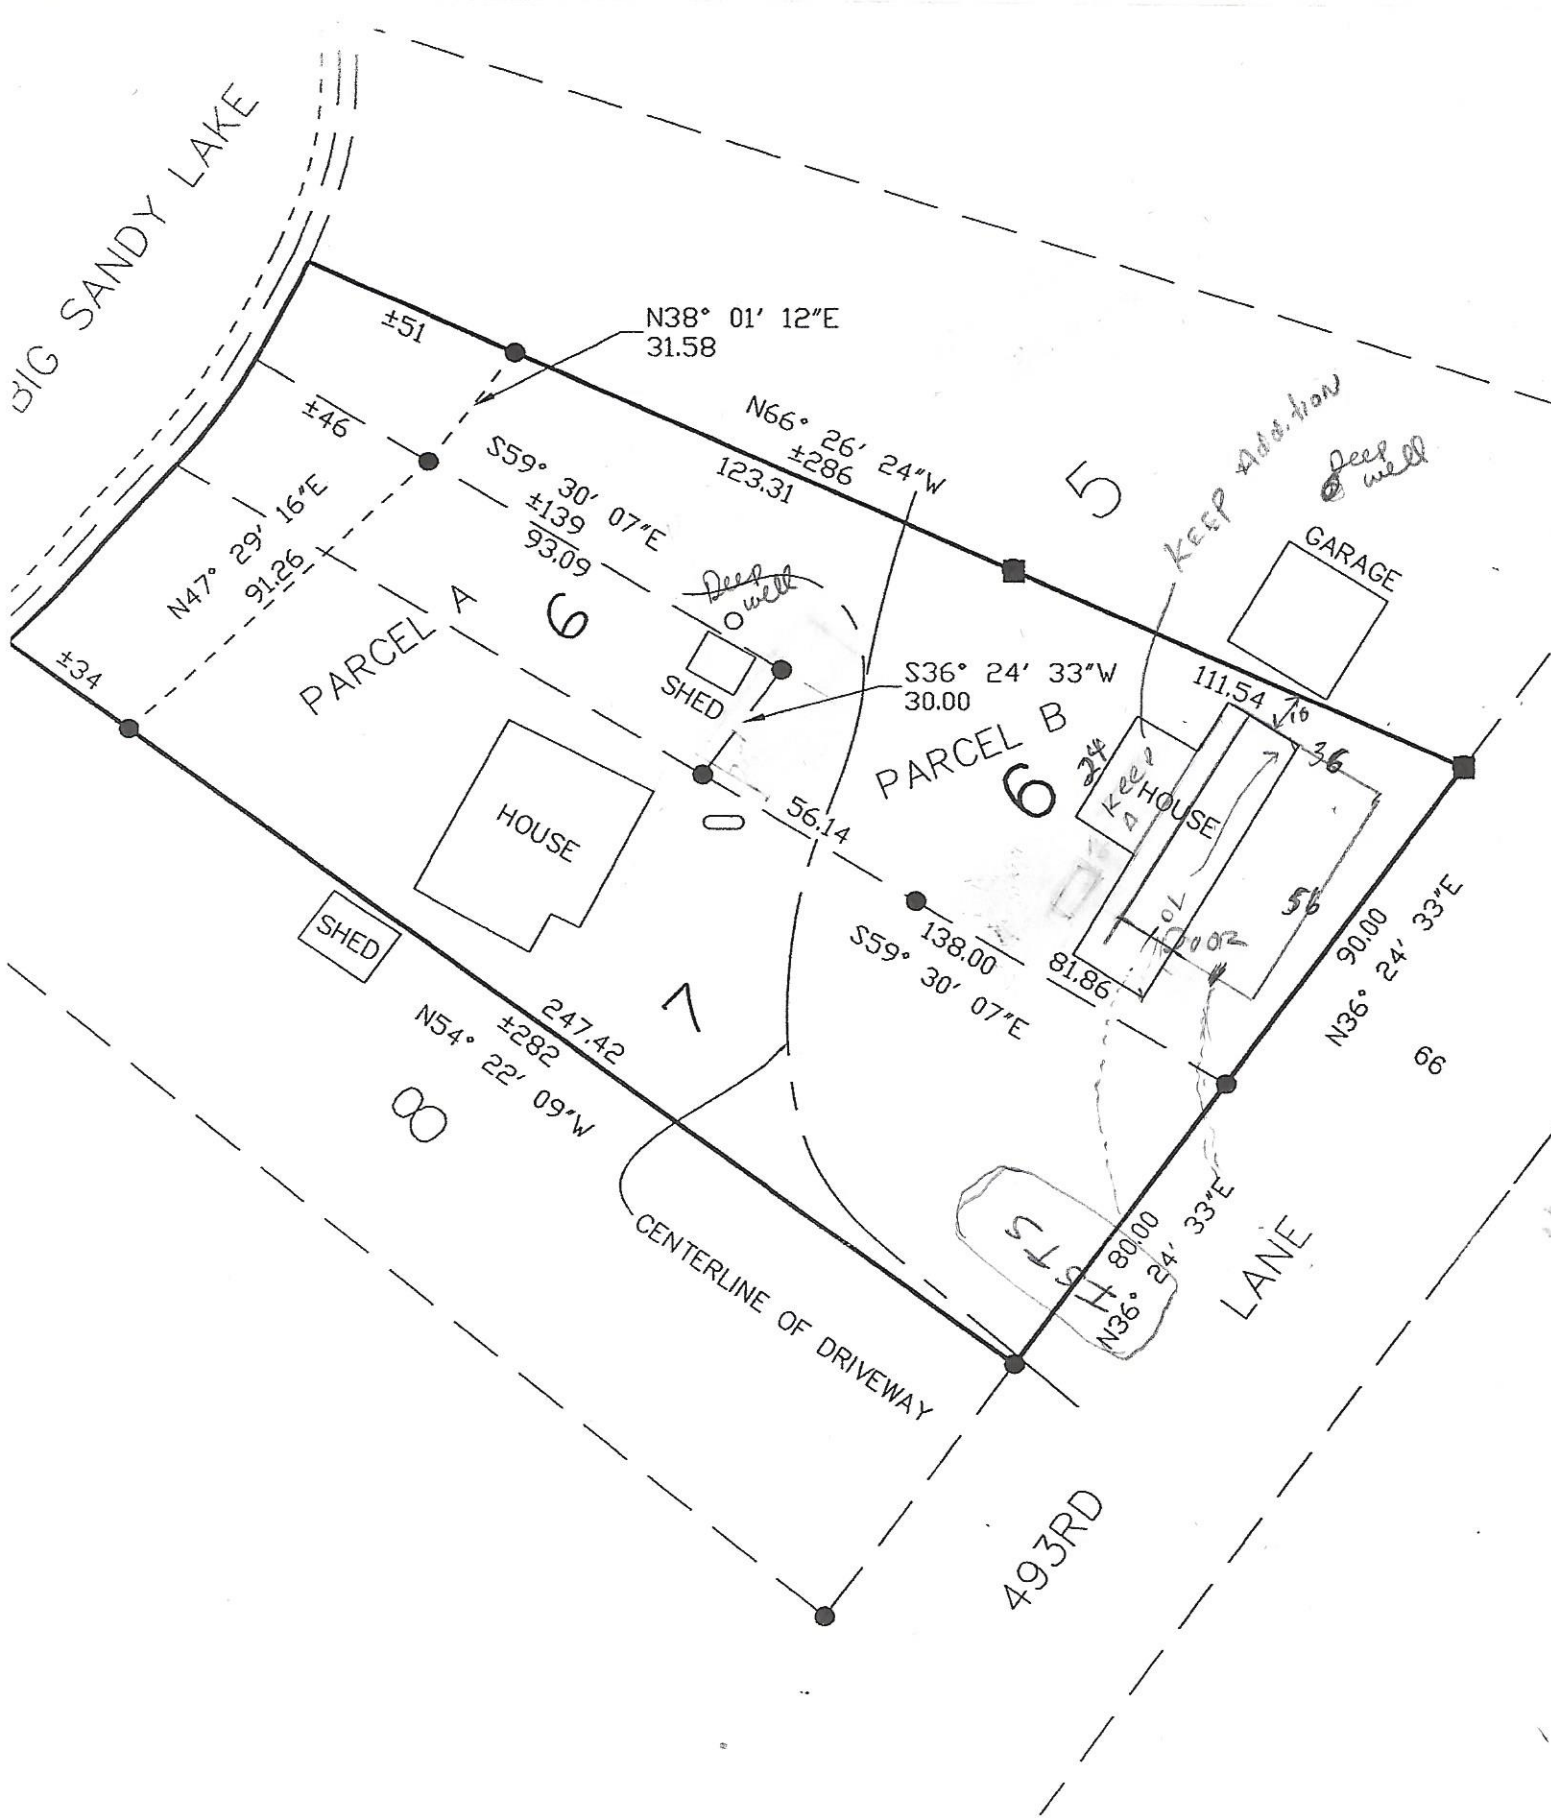

PARCEL A

PARCEL B

SHED

HOUSE

SHED

Deep well

HOUSE

GARAGE

Deep well

Keep Addition

CENTERLINE OF DRIVEWAY

LANE

493RD

∞

5

6

6

66

±34

±46

±51

31.58

123.31

93.09

30.00

56.14

138.00

111.54

90.00

247.42

±282

80.00

N47° 29' 16"E

S59° 30' 07"E

N38° 01' 12"E

N66° 26' 24"W

S36° 24' 33"W

S59° 30' 07"E

N54° 22' 09"W

N36° 24' 33"E

N36° 24' 33"E