



Minnesota Pollution Control Agency

520 Lafayette Road North
St. Paul, MN 55155-4194

SSTS Abandonment Reporting Form

Subsurface Sewage Treatment Systems (SSTS) Program

Instructions

This form is offered to meet the abandonment requirements of Minn. R. 7080.2500 and Disclosure Requirements of Minn. Stat. § 115.55, subd. 6. Future water supply well placement can also be affected by an abandoned SSTS.

The use of this form is not mandatory; however the information on this form must be submitted to the local government unit (LGU) within 90 days after the abandonment. This form may be completed by a certified SSTS practitioner or by an individual who has direct knowledge of how the system was abandoned.

Property Information

Date of abandonment: _____ Reason for abandonment: Failed Septic Drainfield & TANK

Property owner name(s): GERALD and BARBARA OLEJAR

Property owner's address: 7170 OGDEN AVE NE

City: EIK RIVER State: MN Zip: 55330

Site address (if different): 20525 493RD LANE

City: McGregor State: MN Zip: 55760

Compliance Information


- All solids and liquids removed from all tanks? Yes No
Disposal Site: Pumped Prior to purchase TANKS are empty
- All electrical devices and devices containing mercury removed? Yes No
Disposal Site: No Electrical to System - Gravity System
- All underground sewage tanks crushed and filled with soil or rock material? Yes No or
Removed and disposed off site? Yes No
Disposal Site: _____
- Contaminated materials* removed and disposed off site? Yes No
Disposal Site: _____
- All underground cavities** crushed and filled with soil or rock material? Yes No or:
Removed and disposed off site? Yes No
Disposal Site: _____
- Future discharge to system permanently denied? Yes No
Method(s) used: Piping Removed -

*Contaminated materials = Distribution media, soil or sand within three feet of the system bottom, distribution pipes, geotextile fabric/rosin paper/straw, tanks, contaminated soil around leaking tanks, any soil that received sewage from a surface failure (7080.2500 subp.3).

**Underground cavities = Cesspools, leaching pits, drywells, seepage pits, vault privies, pit privies, pump chambers (7080.2500 subp. 1). Does not include chamber media, drop boxes, or distribution boxes.

Map

Include location of building sewer, septic tank(s), soil dispersal system, cesspools, seepage pits, and other pits. Also include a permanent reference point(s) and dimensions.

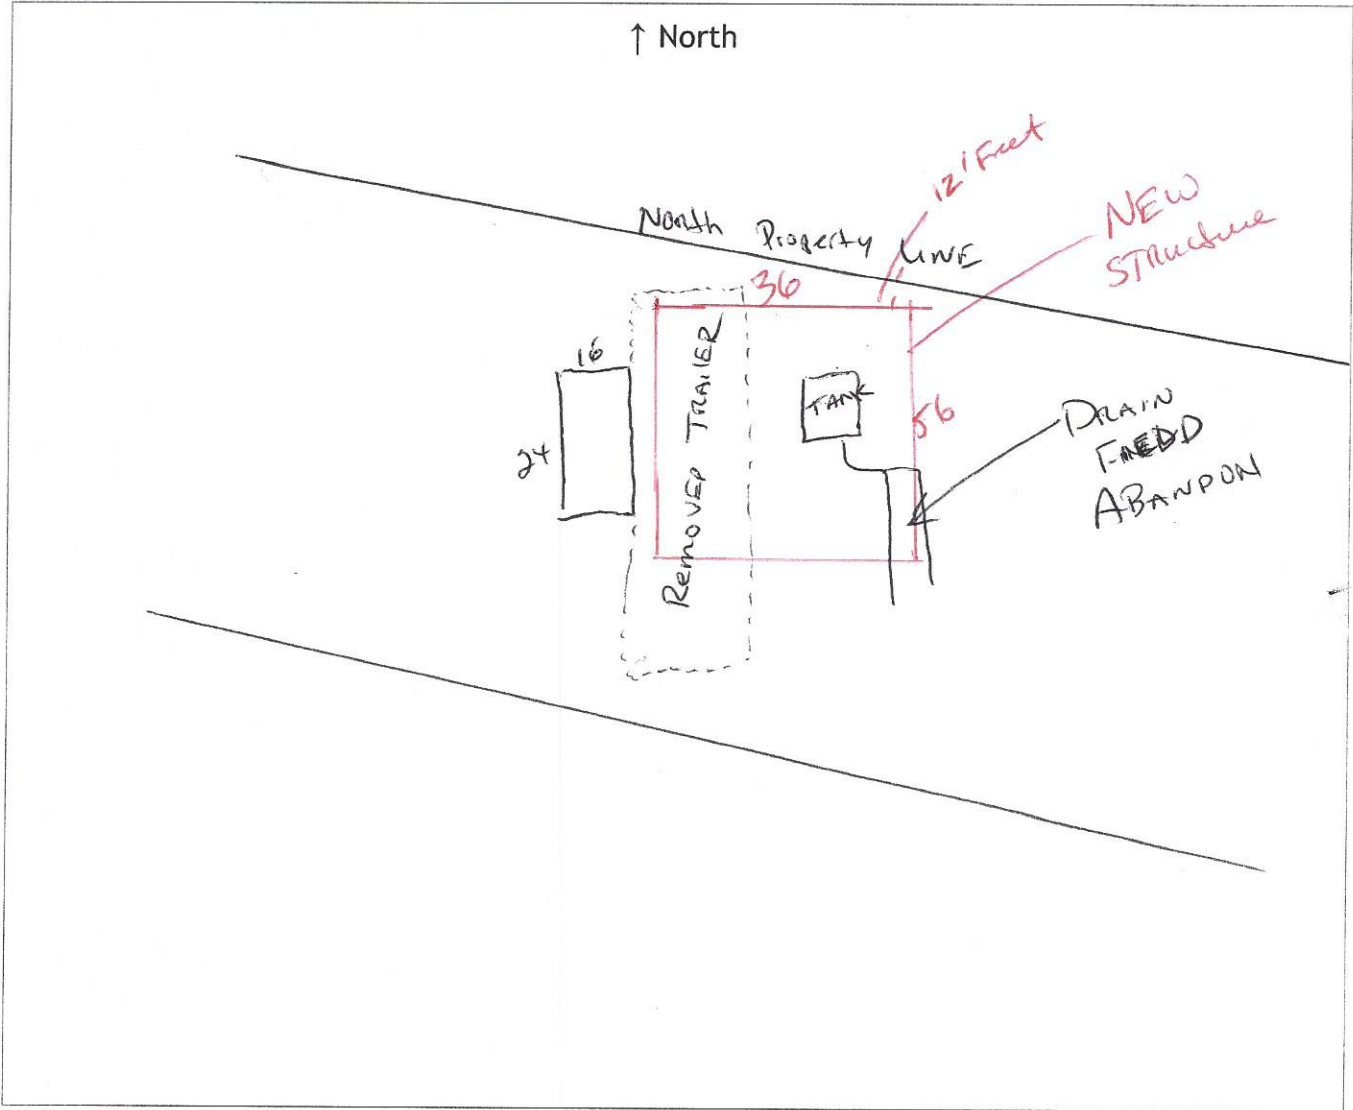

Certification

I hereby certify the system was abandoned in accordance with Minn. R. 7080.2500 and any local requirements.

Name (please print): GERALD OUEJAR Title: _____

Address: 717 Ø OGREN AVENUE

City: EIK RIVER State: MN Zip: 5533Ø

Phone: 612-801-6565 License # if applicable): _____

Date: _____ Signature: _____

DATE NOT YET SET FOR REMOVAL Due to
ROAD Restrictions -