

AITKIN COUNTY
CERTIFICATE OF INSTALLATION/~~NOTICE OF NONCOMPLIANCE~~

This certificate of installation/~~notice of noncompliance~~ has been issued this 23rd day of August, 2022 to certify compliance/~~noncompliance~~ with Aitkin County's Subsurface Sewage Treatment System Ordinance.

The premises covered by this certificate are legally described as: _____
LOT 6 BLK 1 FLEMING HEIGHTS

Section 21 Township 48 Range 25 Lake Fleming
PERMIT NO. 45649 Owner Name Joseph & Joanne Gibbs
Address 52450 310th Pl Aitkin, Mn 56431
Installer Name Ritter Sewer & Excavating
Type of System Inspected 2 Bdrm Type I Mound
Parcel Number 08-1-088000

The certificate of installation/~~notice of noncompliance~~ was based on No 1 of the following:

- 1) Inspection of the installation or construction as in accordance with the above referenced permit and application design.

- 2) Review of as-built plans submitted in accordance with Subdivision 9.2 D of Aitkin County's Subsurface Sewage Treatment System Ordinance.

If the above permitted subsurface sewage treatment system is in noncompliance with Aitkin County's Subsurface Sewage Treatment System Ordinance, then the following shall serve as a Notice of Violation:

- 1) Statement of the findings of fact through inspections or investigations:

2) List of specific violations of Ordinance: _____

3) Requirements for correction or removal of violations: _____

4) Time schedule for compliance: _____

Failure to correct or remove the above violation(s) will result in this matter being turned over to the Aitkin County Attorney's Office for further legal action, which may result in revocation of licenses, fines and/or imprisonment.

INSPECTOR SIGNATURE _____



**SUBSURFACE SEWAGE TREATMENT SYSTEM INSPECTION FORM
AITKIN COUNTY, MINNESOTA**

Township Fleming Date of Inspection 8-3-28 Tank/Final
7-30-21 mound/1 App. Number 2021-007218
 Owner Joseph + Joanne Gibbs Parcel Number 08.1-088000
 Project Address 42451 31st Pl Installer Ritter Sewer
 City Aitkin Zip Code 56431

New Repair

SETBACKS:

Buildings to tank(s) 62'
 Buildings to drainfield ~120'
 Well(s) 50' or 100' ~130'
 Lake/Creek/Wetland >100'

SEPTIC TANKS: New Existing
 Number of tanks installed 1 Jacobson 1650
 Liquid capacity and type 1120 Precast
 Type of baffle Plastic
 Inspection pipes —
 Manholes size 2 @ 24" 1 @ 20"
 Manhole to grade Yes No

PUMPS: New Existing
 Tank capacity and type 530 Precast
 Pump manufacturer & model # Coalds PE41
 Horsepower & GPM 4hp 18gpm
 Feet of head 21'
 Gallons per cycle 45
 Size of discharge line 2"
 Type & location of alarm Elec @ Tank
 Water meter —


DIST. or DROP BOX & TYPE _____

TRENCHES, BEDS, OR GRAVELLESS LEACHFIELD:

Trench/Bed depth _____
 Trench/Bed length _____
 Trench/Bed bottom width _____
 Trench spacing _____
 Drainfield rock below pipe _____
 Size of gravelless pipe _____
 Depth of backfill _____
 Absorption area: square feet _____
 lineal feet _____

MOUNDS:
 Percent slope 5
 Upslope sand width 12
 Downslope sand width 20
 Sideslope sand width 12 west 14' east
 Drainfield rock below pipe 9"
 Depth of sand below rock 18"
 Perforation size & spacing 1/4 x 3
 Pipe size & spacing 1 1/2 x 3
 Dimensions of rock bed 12 x 25
 Dimensions of sand base 42 x 51
 Final cover 18" T 12" S

DRAWING OF SYSTEM: (include soils)

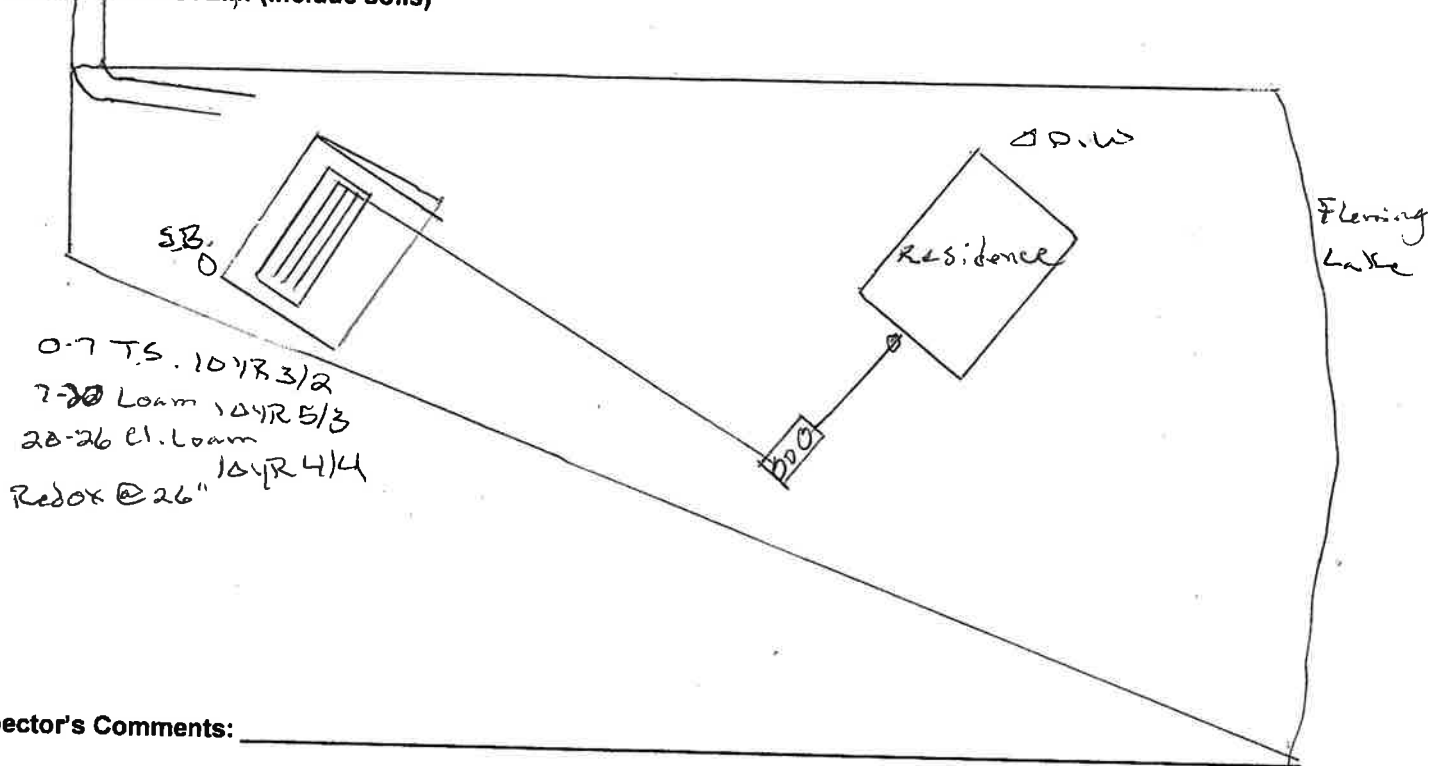

Inspector's Comments: _____
 Inspector's Signature _____ Installer's Signature _____



Certification of Buried Sewer Construction and Testing

This form must be completed and submitted to the Minnesota Department of Health (MDH) for installation of a buried sewer located 20 to 50 feet from a water-supply well, or the installation of a water-supply well located 20 to 50 feet from a buried sewer. **NOTE:** A 50-foot minimum separation must be maintained between a water-supply well and a buried collector or municipal sewer, an unapproved sewer, or a buried sewer serving a facility handling infectious or pathological waste.

Owner of Property Where Sewer is Located (please print)

Joanne Gibbs

Street Address, City, ZIP for Property Where Sewer is Located

42450 310th place Aitkin MN 56431

County Name

Aitkin

Township No.

48

Range No.

25

Section No.

24

Fraction

1/4

1/4

1/4

Date of Testing (mm/dd/yyyy)

07/06/2022

Person(s) Present to Witness Testing

Travis Ruschmeier, Dominic Mindrum

Well Information

Provide Minnesota Well and Boring Number(s) _____ or, if unavailable, provide the following information for each well located within 50 feet of the buried sewer.

Well No./Description	Well Depth	Well Diameter	Year of Construction	Well Contractor Company Name	Well Address (if different from above)

Variance Information

Was a variance issued by the MDH for this sewer or well installation? Yes No

If yes, please provide the variance tracking number: TN _____.

Sewer Materials

- ABS (ASTM D2661)
- PVC (ASTM D2665)
- PVC (ASTM F891)

- ABS (ASTM D2751)
- PVC (ASTM D3034)
- Cast Iron _____

- ABS (ASTM F628)
- PVC (ASTM F789)

Test Methods (check one)

- Air Test (5 psi constant pressure for 15 minutes).
- Manometer Test (1-inch water column).
- Hydrostatic Test (for plastic pipe only).


The portion of the buried sewer system tested is described as follows (please specify each segment of sewer pipe which was tested).

installed clean-out at point of hook-up to existing pipe
with approximately 80' of new pipe to septic tank

Please draw a diagram of the sewer system on back and note the locations of any wells and the portions of the sewer system that were pressure tested.

Buried Sewer Testing Diagram

Please draw a site diagram of the sewer system and all buried sewer pipes, including those buried beneath buildings (serving floor drain[s], bathroom[s], laundry room, etc.). Please note the portions of the buried sewer pipes that were pressure tested, the location of the well(s), and major landmarks on the property.

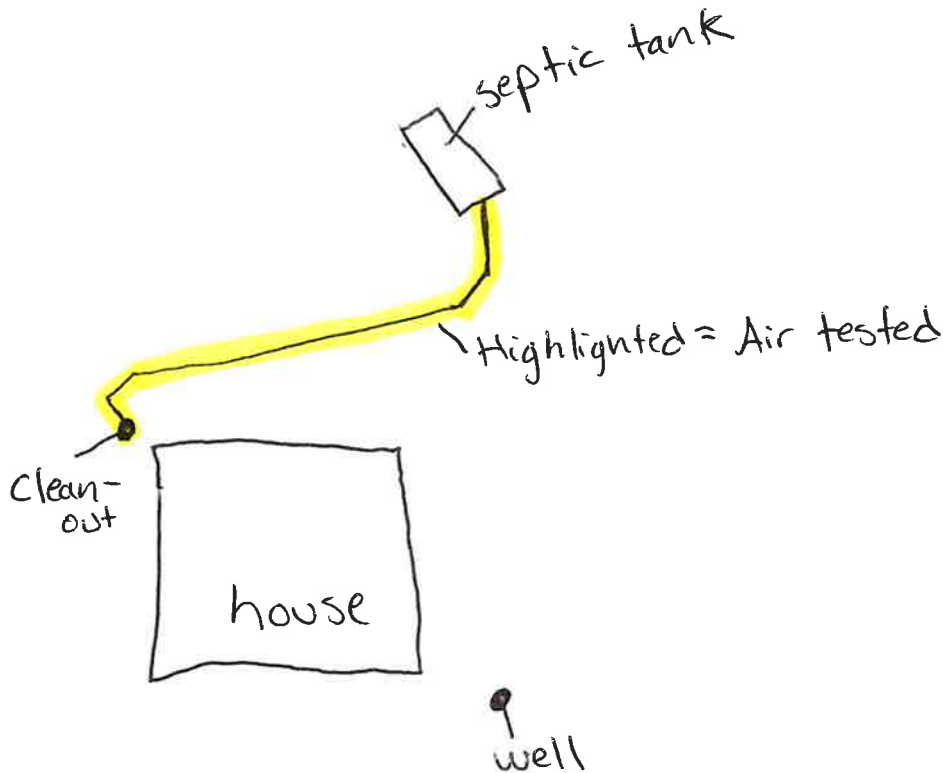

I, (name) Travis Ruschmeier, certify that the buried sewer(s) described above is/are constructed of the indicated, approved sewer material meeting the requirements of the Minnesota Plumbing Code, Minnesota Rules, part 4715.0530, and has/have been successfully tested in accordance with Minnesota Rules, part 4715.2820, by the indicated method.

In accordance with Minnesota Statutes, section 144.992, persons submitting false information to the Minnesota Department of Health are subject to administrative penalties of up to \$10,000.

Name <u>Travis Ruschmeier</u>		Title <u>Foreman</u>	
Firm <u>Ritter Sewer & Excavating Inc.</u>			
Street Address <u>34753 390th Place</u>			
City <u>Aitkin</u>		State <u>MA</u>	ZIP Code <u>56431</u>
License/Certification Number <u>698 #</u>	Signature 		Date <u>7/12/2022</u>

Ritter Sewer
7-6-22

JACOBSON PRECAST CONCRETE, LLC

6:46

42450 3rd Place
A:tkin

TANK INSTALLATION INSTRUCTIONS

Model # 1650 Date Built: 5-9-22 Gallons: 1650 Bury Depth 2'
#2
Model # _____ Date Built: _____ Gallons: _____ Bury Depth _____

SITE CONDITION:

The site must be accessible to large, heavy trucks. Free of items like trees, stumps, overhead wires, etc. That could interfere with delivery or installation and allows trucks to within 3 to 5 ft of placement excavation.

EXCAVATION:

Excavation should be approximately 12" minimum larger than tank size to allow for adequate back fill. This may vary with soil conditions. Excavation shall have a level bottom so the weight bears on the outside walls of the tank.

BEDDING:

Each tank should be placed on about 6" of proper bedding material leveled, and should be compacted to minimum 95% compaction if tested, to ensure the life of the tank structure. Bedding must be capable of bearing the weight of the tank. Bedding material shall have the ability of 100% to pass through a 1/2" screen.

WATER TABLE:

When tanks are being placed where water levels can potentially be higher than the elevation of the tank cover, an alternate location should be considered. If water table is high installer must also consider the tank may float, if this is a possibility tank must be tied down before backfilling.

BACKFILL MATERIAL:

Sidewall of tanks require dry backfill materials that have the ability of 100% to be able to pass through a 2" screen and a minimum of 12" on all sides from the bottom to top of tank. Backfill material shall be placed to avoid impact loads on sidewall of the tank.

COVER MATERIAL:

Cover material shall be dry soil, material that has the ability of 100% to be able to pass through a 2' screen. Cover material shall be mounded over tank and around risers to direct run-off away from both.

INLET & OUTLET:

Pipe not to exceed 1" past the interior wall of tank where a baffle is used.

BURIAL DEPTH: Tanks to be installed according to model's maximum bury recommendations: