



Pit 0-9 T.S. Sandlon 7.5yr 3/2
 5-19 Med Sand 7.5yr 4/3
 Loom
 Redol 19" AD 11

B-1 0-8 T.S. 7.5yr 3/2
 Sand Loom


8-24 Sand Loom 7.5yr 4/4
 Redol at SW west
 note 2' eyes on side
 1' Eyes on end PS

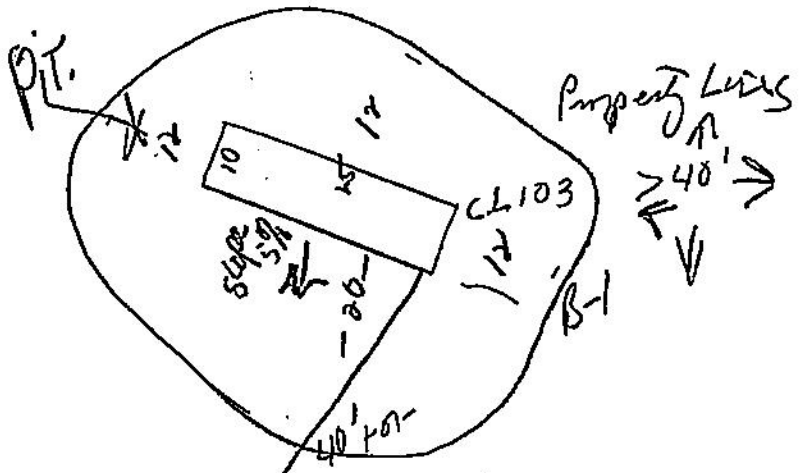

Property Line


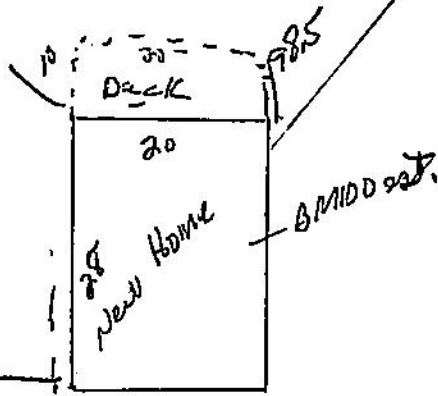


98.5 Line at home
 97.5 TANK inlet
 95.0 Pump
 103 Grout at R.B
 104.5 Bottom of Rock
 105.4 Dist Pipe
 60' TAN
 79.5
 To well
 7000'

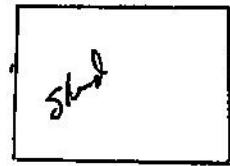

← 36

Adopt 23

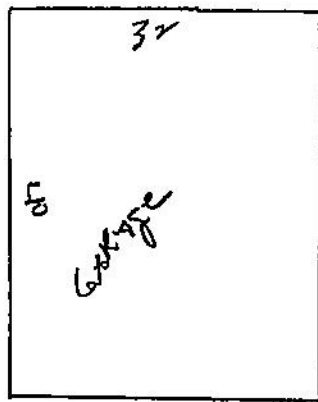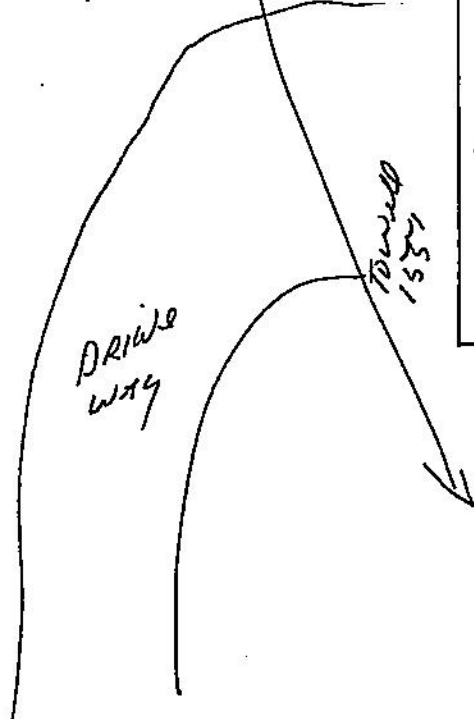

Done by hand
 L2006 5/5/2021