

AITKIN COUNTY
CERTIFICATE OF INSTALLATION/~~NOTICE OF NONCOMPLIANCE~~

This certificate of installation/~~notice of noncompliance~~ has been issued this _____ day of _____, 20____ to certify compliance/~~noncompliance~~ with Aitkin County's Subsurface Sewage Treatment System Ordinance.

The premises covered by this certificate are legally described as: _____

Section _____ Township _____ Range _____ Lake _____
PERMIT NO. _____ Owner Name _____
Address _____
Installer Name _____
Type of System Inspected _____
Parcel Number _____

The certificate of installation/~~notice of noncompliance~~ was based on No ___ of the following:

- 1) Inspection of the installation or construction as in accordance with the above referenced permit and application design.

- 2) Review of as-built plans submitted in accordance with Subdivision 9.2 D of Aitkin County's Subsurface Sewage Treatment System Ordinance.

If the above permitted subsurface sewage treatment system is in noncompliance with Aitkin County's Subsurface Sewage Treatment System Ordinance, then the following shall serve as a Notice of Violation:

- 1) Statement of the findings of fact through inspections or investigations:

- 2) List of specific violations of Ordinance: _____

- 3) Requirements for correction or removal of violations: _____

- 4) Time schedule for compliance: _____

Failure to correct or remove the above violation(s) will result in this matter being turned over to the Aitkin County Attorney's Office for further legal action, which may result in revocation of licenses or registrations, fines and/or imprisonment.

INSPECTOR SIGNATURE _____

**SUBSURFACE SEWAGE TREATMENT SYSTEM INSPECTION FORM
AITKIN COUNTY, MINNESOTA**

Township Ball Bluff Date of Inspection 8/13/2021 App. Number 46090

Owner James Hennen Parcel Number 02-0-029601

Project Address 67432 St. Hwy 65 Installer Red Kern

City Jacobson Zip Code 55752 T2 HT

New Repair

DIST. or DROP BOX & TYPE _____

SETBACKS:

Buildings to tank(s) 13'

Buildings to drainfield _____

Well(s) 50' or 100' DW: 72'

Lake/Creek/Wetland _____

TRENCHES, BEDS, OR GRAVELLESS LEACHFIELD:

Trench/Bed depth _____

Trench/Bed length _____

Trench/Bed bottom width _____

Trench spacing _____

Drainfield rock below pipe _____

Size of gravelless pipe _____

Depth of backfill _____

Absorption area: square feet _____

lineal feet _____

SEPTIC TANKS:

New Existing

Number of tanks installed 1

Liquid capacity and type 1820 Jec. Combo

Type of baffle Plastic

Inspection pipes _____

Manholes size 24"

Manhole to grade Yes No

MOUNDS:

Percent slope _____

Upslope sand width _____

Downslope sand width _____

Sideslope sand width _____

Drainfield rock below pipe _____

Depth of sand below rock _____

Perforation size & spacing _____

Pipe size & spacing _____

Dimensions of rock bed _____

Dimensions of sand base _____

Final cover _____

PUMPS:

New Existing

Tank capacity and type _____

Pump manufacturer & model # _____

Horsepower & GPM _____

Feet of head _____


Gallons per cycle _____

Size of discharge line _____

Type & location of alarm Manual popup

Water meter _____

DRAWING OF SYSTEM: (include soils)

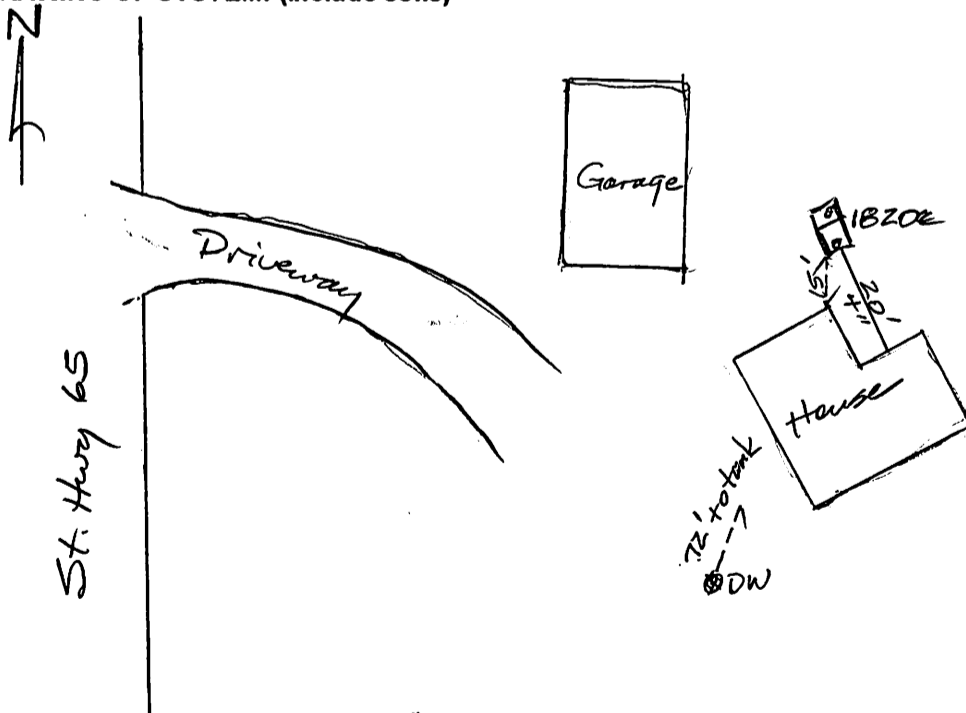

Inspector's Comments: 20' 4"

Inspector's Signature Bryan Hargrave Installer's Signature _____



2021/08/13



2021/08/13