


# BUILDINGS (CURRENTLY)

#1 - 18' x 22' CABIN

#2 - 20' x 24' BUNK HOUSE

#3 - 10' x 12' SHED

#4 - 8' x 10' OUT HOUSE / SHED

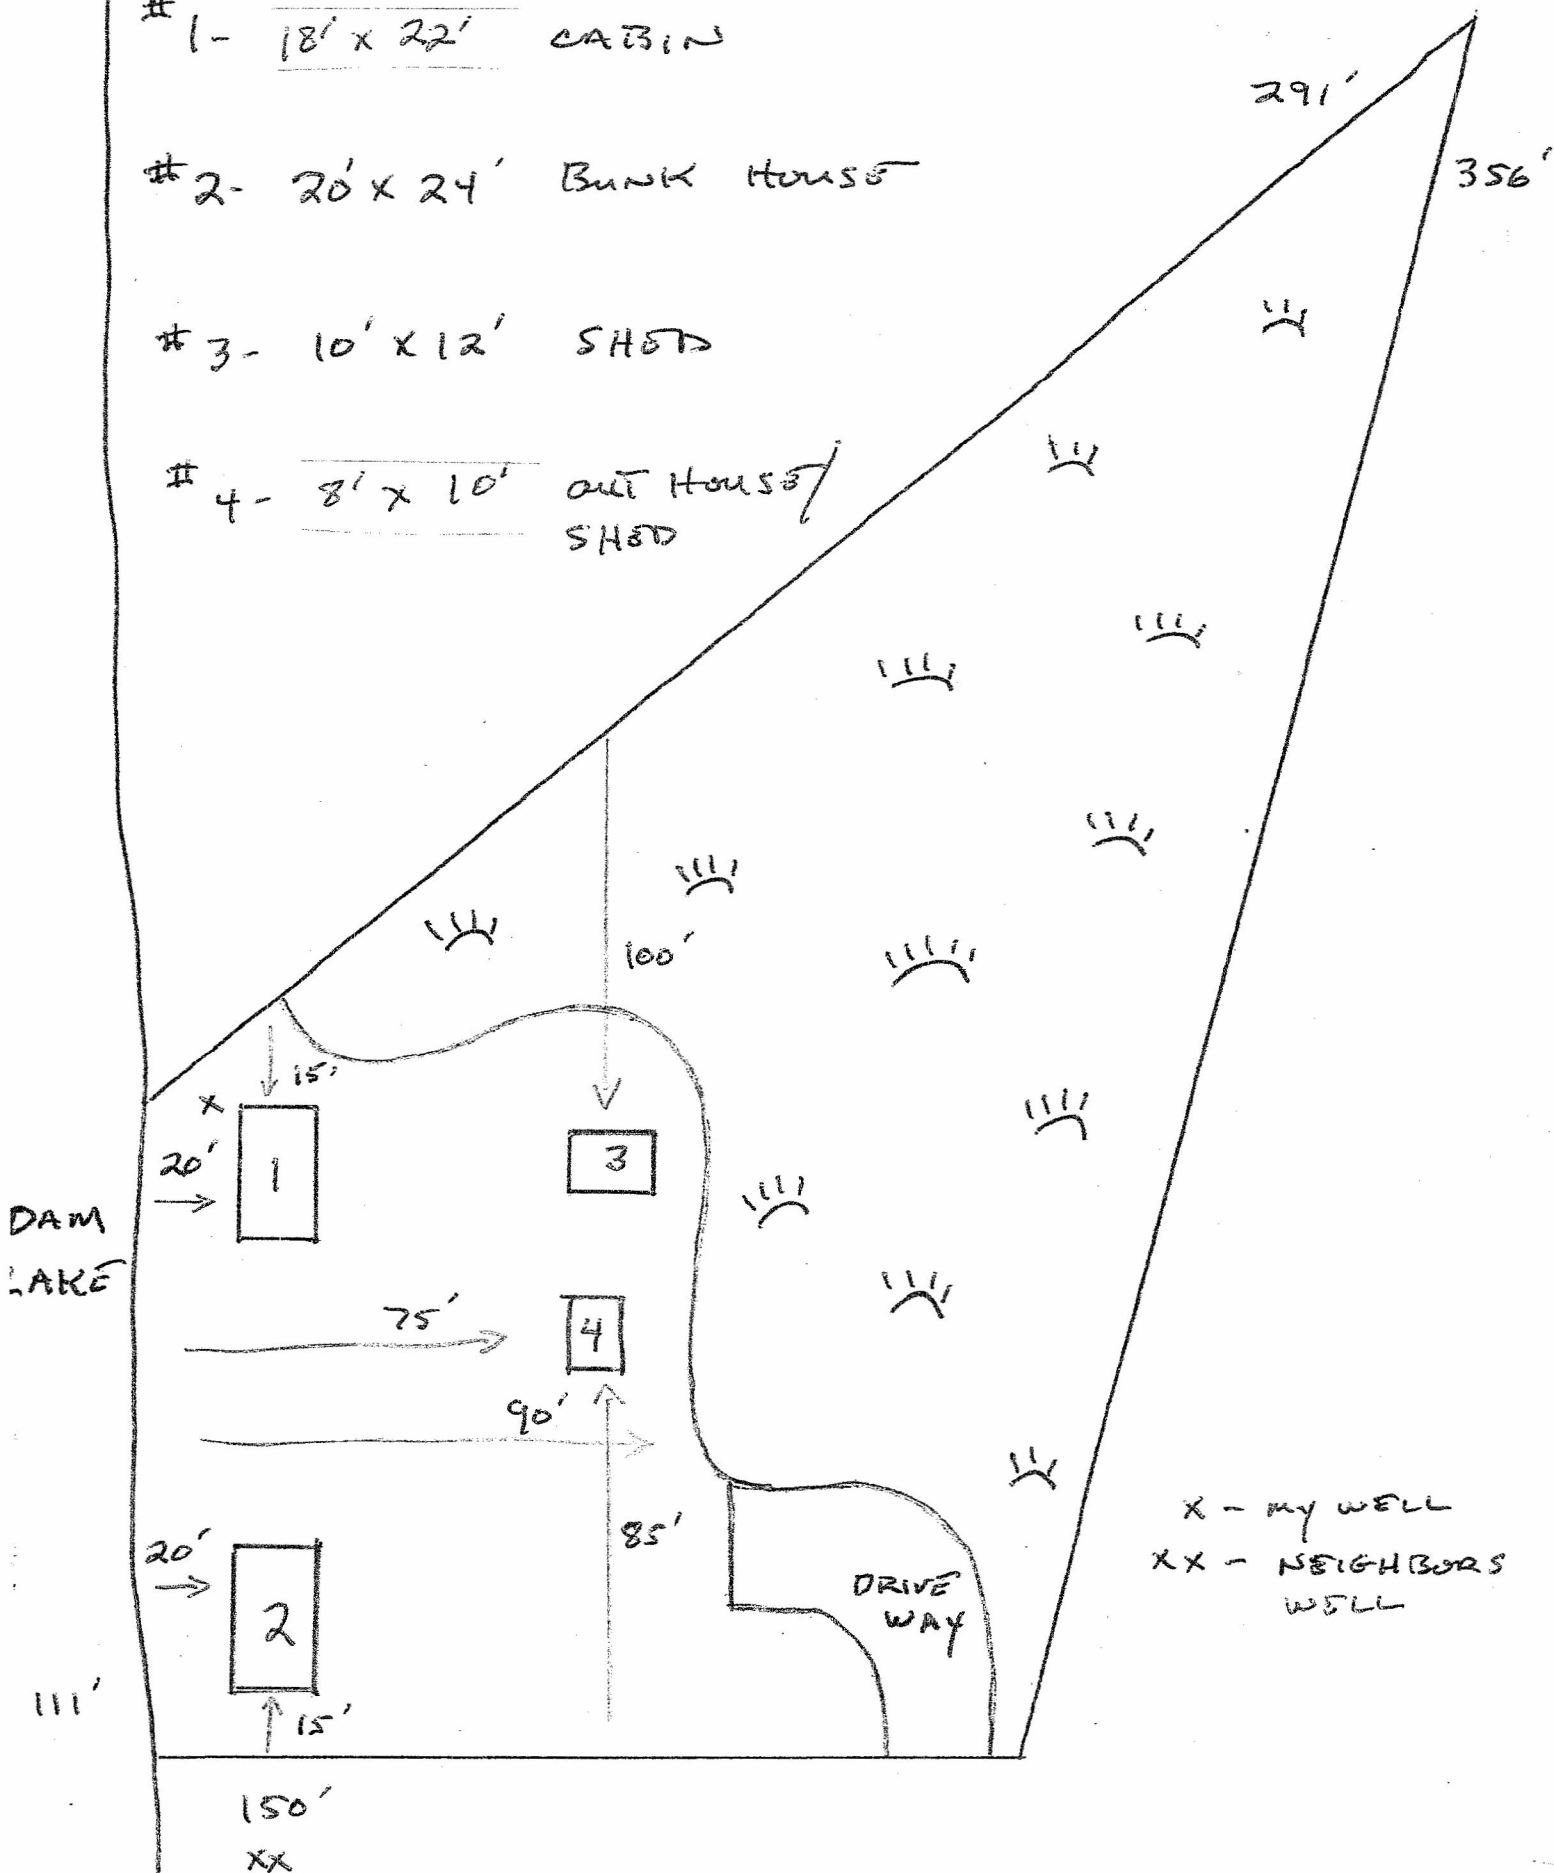

X - my well  
XX - neighbors well

PROPOSED 5-12-20

- #1 18' x 30' CABIN WITH 3' ADDITION
- #2 20' x 24' BUILDING (EXISTING)
- #3 10' x 12' SHED (REMOVED)
- #4 8' x 10' OUTHOUSE/SHED (REMOVED)
- #5 24' x 32' ATTACHED GARAGE (NEW)
- #6 7' x 30' SEPTIC TANKS (NEW)
- #7 8' x 12' RAIN GARDEN
- #8 15' x 30' DRIVE WAY
- X MY WELL
- XX NEIGHBORS WELL

DAM LAKE

